


T. 34 S. R. 1 W. W. M.

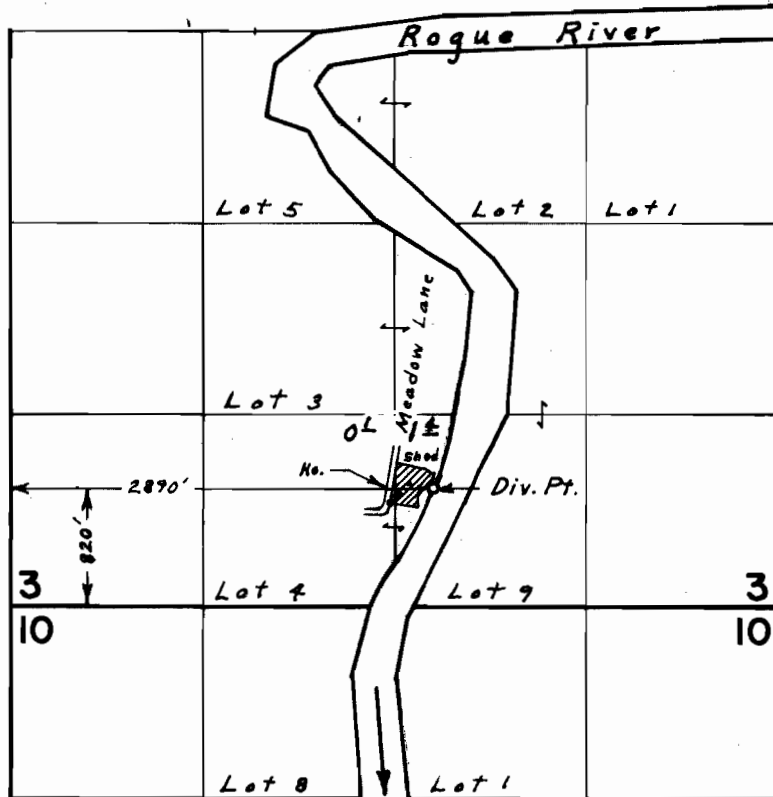

FINAL PROOF SURVEY
UNDER

Application No. 43484 Permit No. 32524
IN NAME OF

JEANETTE A. ENYART

Surveyed May 4, 1971, by L. E. Gould