


T. 34 S. R. 1 W. W. M.

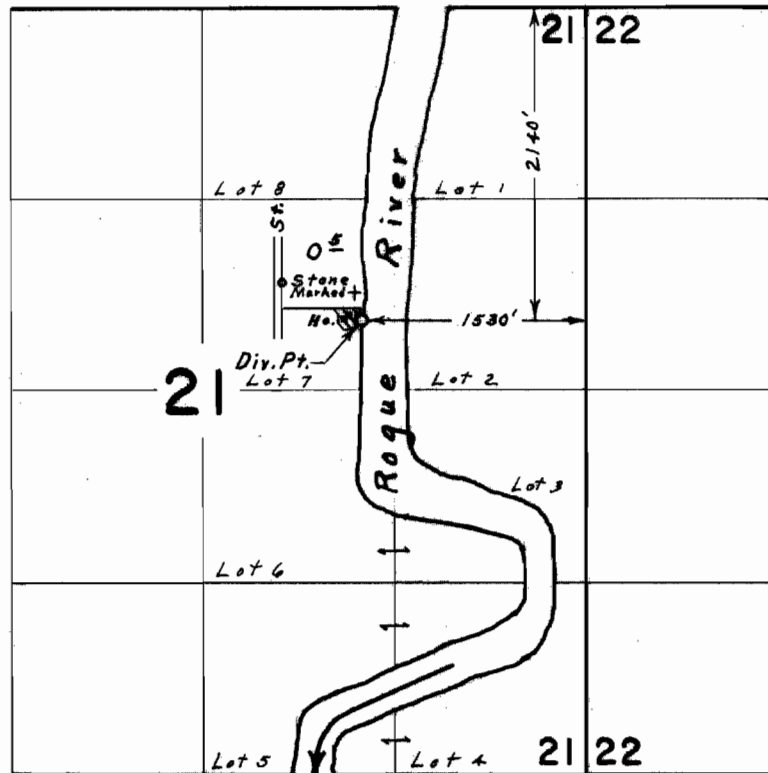

FINAL PROOF SURVEY UNDER

Application No. 43603 Permit No. 32607
IN NAME OF

Mr. & Mrs. ROLLEN H. SOMER

Surveyed May 6, 1971, by L. E. Gould