


T. 3 4 S. R. 1 W. W. M.

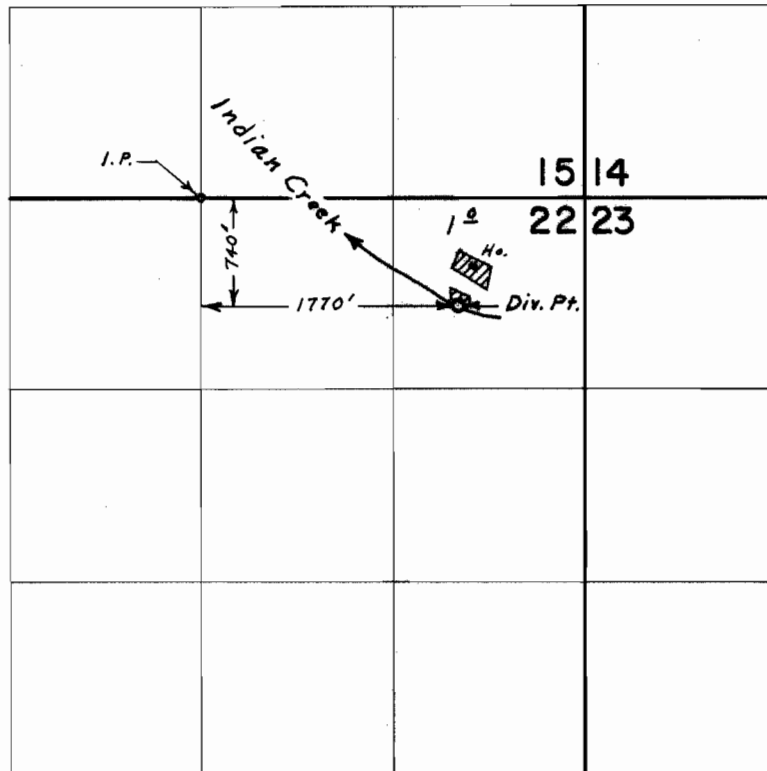

**FINAL PROOF SURVEY**  
UNDER

Application No. 43646 Permit No. 32628  
IN NAME OF

LELAND C. & BETTY J. LINDSLEY

Surveyed May 7, 1971, by L. E. Gould