


T. 3 4 S. R. 1 W. W. M.

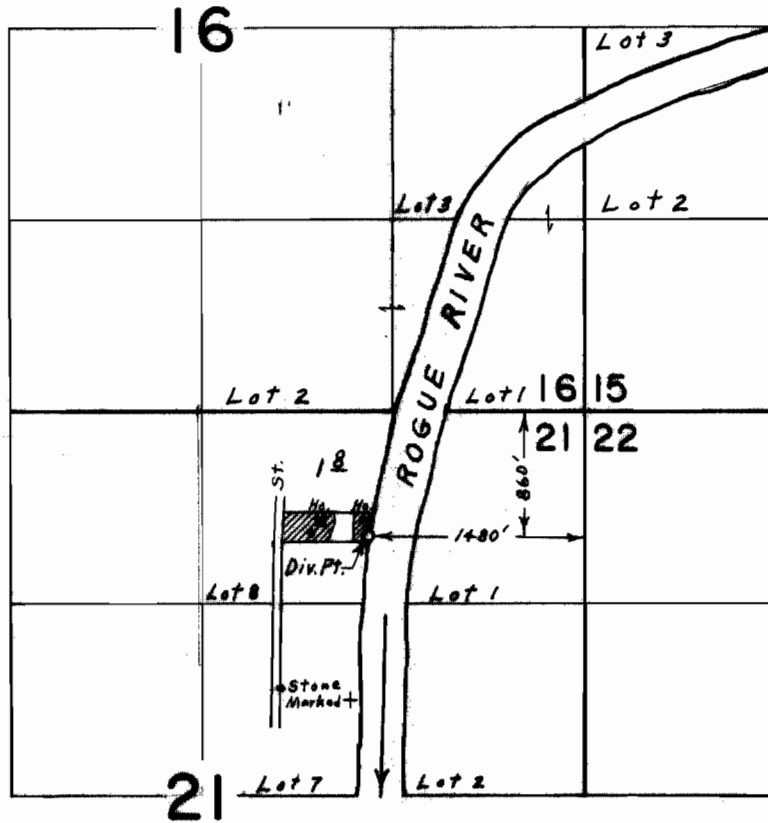

FINAL PROOF SURVEY
UNDER

Application No. 44881 Permit No. 33556
IN NAME OF

TED R. FLURY

Surveyed May 6, 1971, by L. E. Gould