


T. 32 S. R. 3 E. W. M.

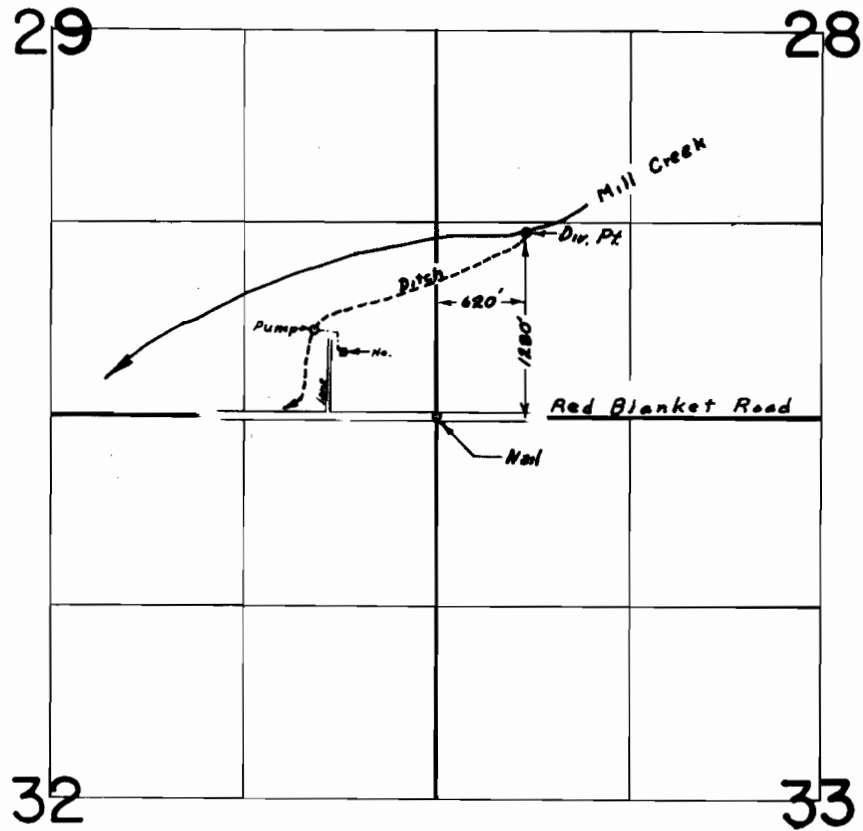

FINAL PROOF SURVEY
UNDER

Application No. 45148..... Permit No. 33729.....
IN NAME OF

.....LARRY MULLINNIX.....

Surveyed SEP. 15., 1971., by L. E. Gould.....