


T. 34 S. R. 1 W. W. M.

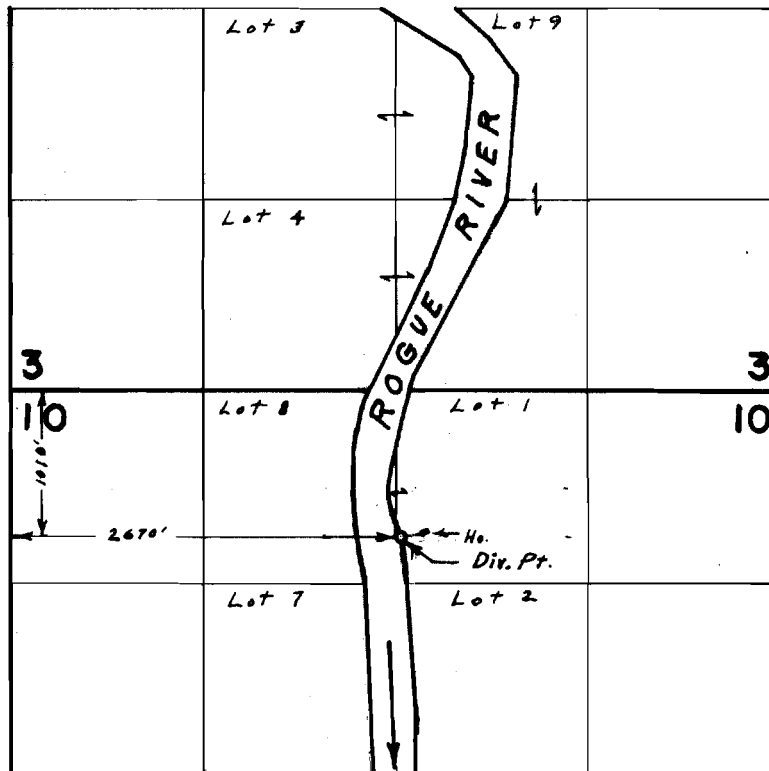

FINAL PROOF SURVEY
UNDER

Application No. 45552 Permit No. 33986
IN NAME OF

HAROLD W. HALL

Surveyed May 4, 1971, by L. E. Gould