


T. 34 S. R. 1 W. W. M.

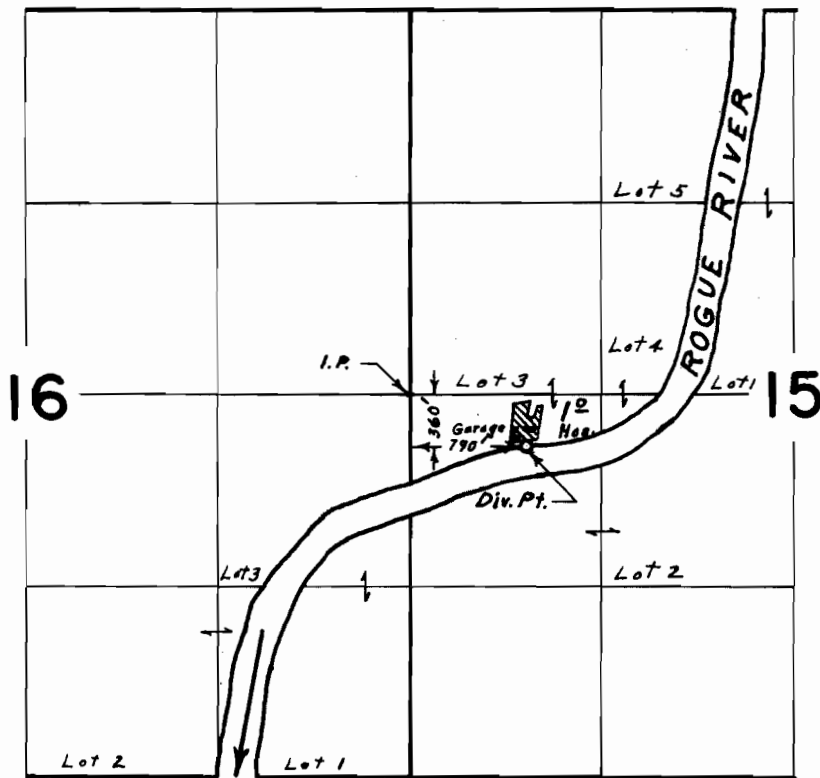

FINAL PROOF SURVEY
UNDER

Application No. 46109 Permit No. 34448
IN NAME OF

LOIS S. BISHOP

Surveyed May 5, 1971, by L. E. Gould