


G - 3735

38564

T.4S.R10E.W.M.

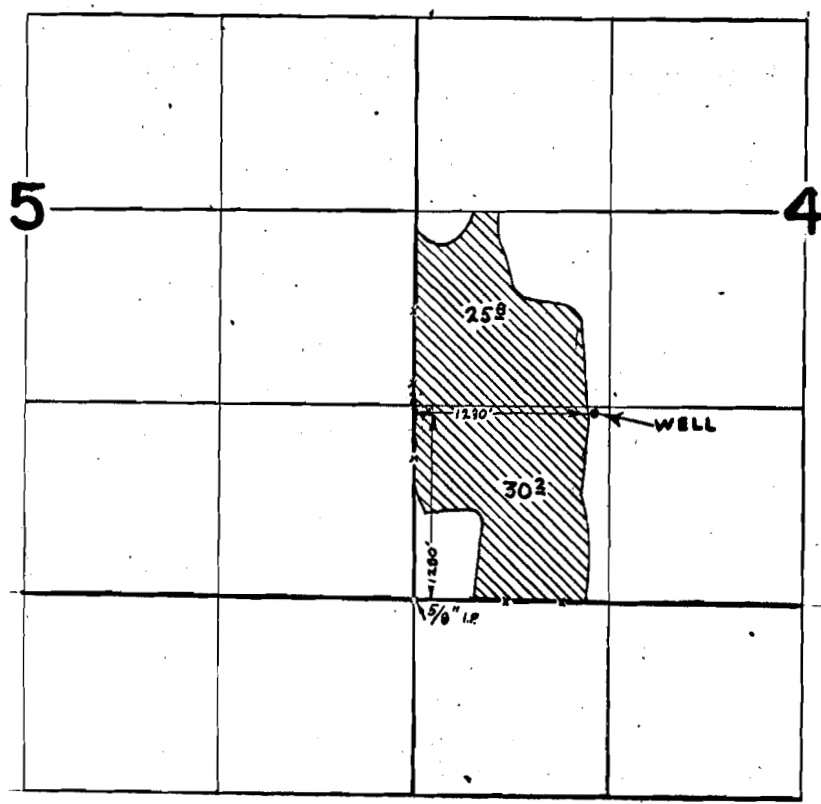

Just River Wells

FINAL PROOF SURVEY UNDER

Application No. G. 3978 Permit No. G. 3735
IN NAME OF

GEORGE ROBERT BURRELL

Surveyed SEP. 17, 1971, by R. MUGKEN