


T.39S.R.20E.W.M.

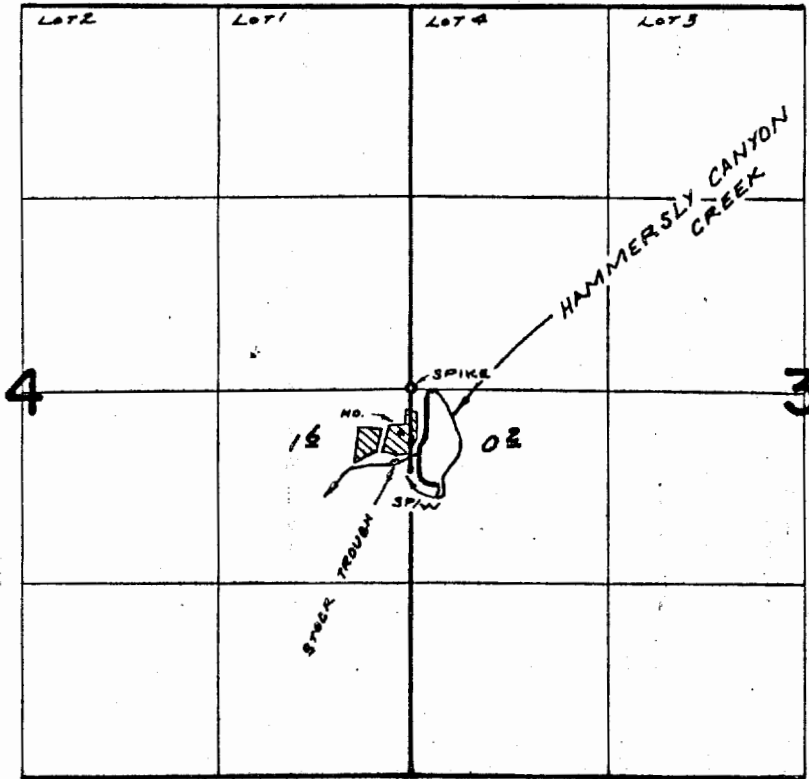

DIV. PT. LOC: 440'S. & 70'E. FROM W 1/4 COR. SEC. 3

FINAL PROOF SURVEY

UNDER

Application No. R-42899 42900 Permit No. R-4795 31591

IN NAME OF

JIM SNIDER

Surveyed July 16, 1970, by R. MUCKEN