


38566

31591

# T.39S.R.20E.W.M.

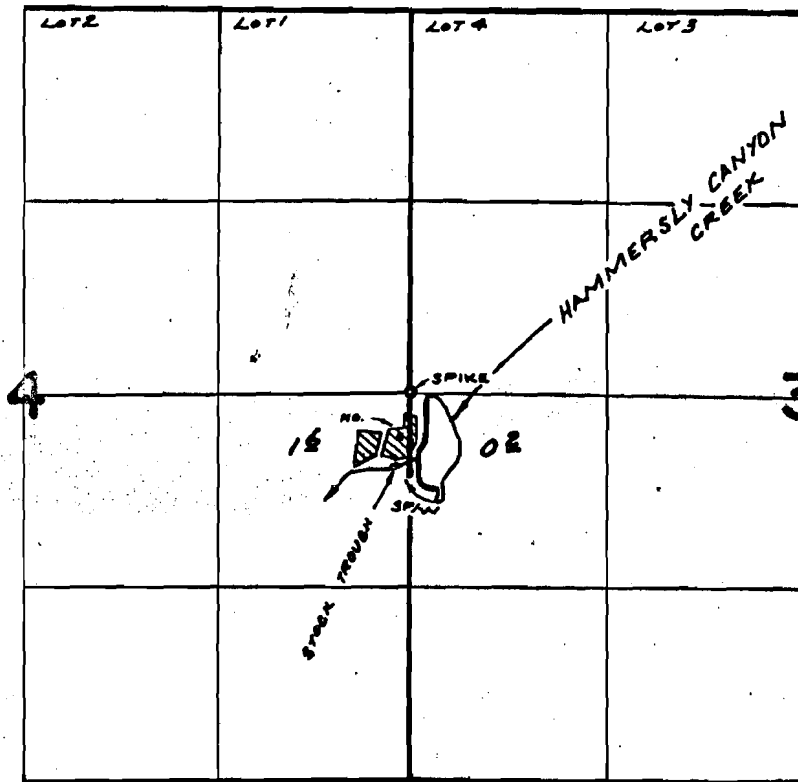

DIV. PT. LOC: 440'S. & 70'E. FROM W 1/4 COR. SEC. 3

## FINAL PROOF SURVEY

UNDER

Application No. ~~R-42899~~ 42900 Permit No. ~~R-4795~~ 31591

IN NAME OF

JIM SNIDER

Surveyed July 16, 1970, by R. MUCKEN

39-20 ✓