


# T. 15 S. R. 4 W. W. M.

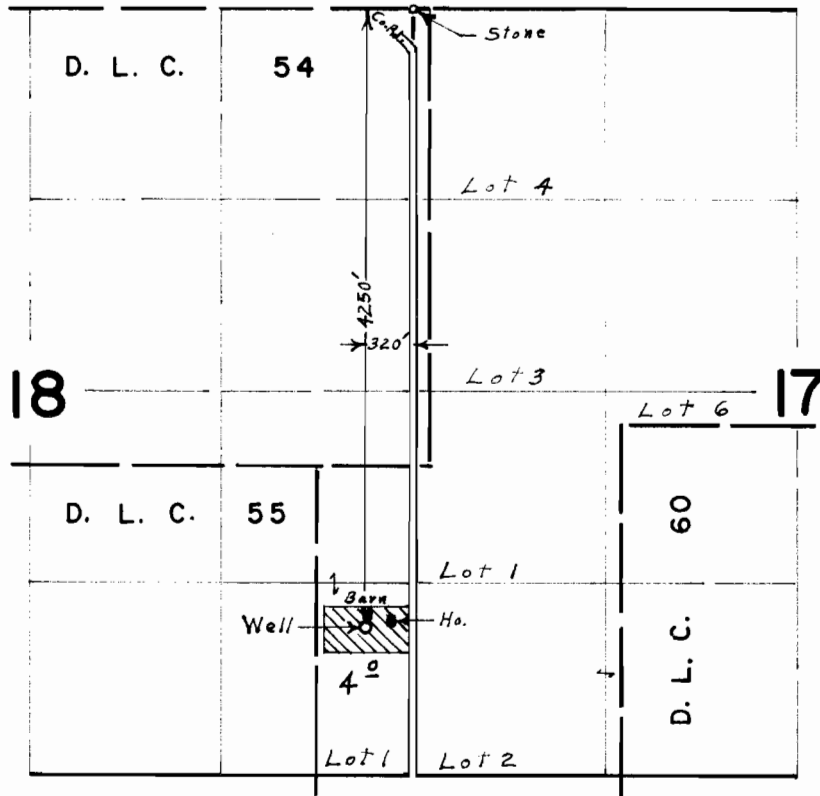

MONARCH LAND INVESTMENT

PLAT

Approved by G-4608 and G-4332

Notary Public

JAMES D. & VIOLET GRIFFITH

Witnessed June 4, 1970 by L. E. Gould