


T.16 & 17 S. R.3 W. W.M.

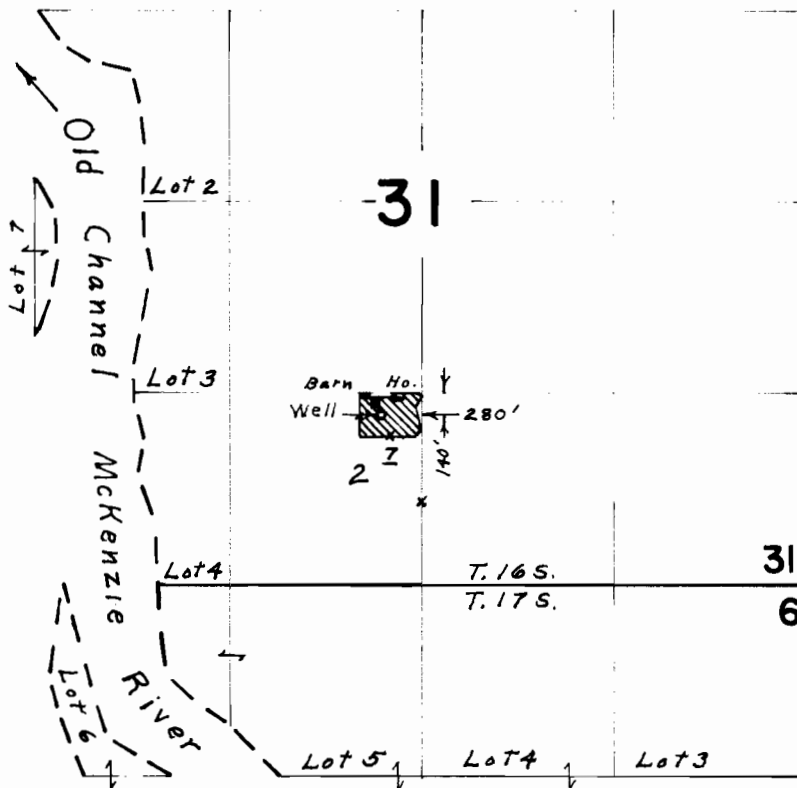

G-4622

G-4434

GEORGE V. KNOX

June 18, 70

L. E. Gould