


T. 18 S. R. 4 W. W. M.

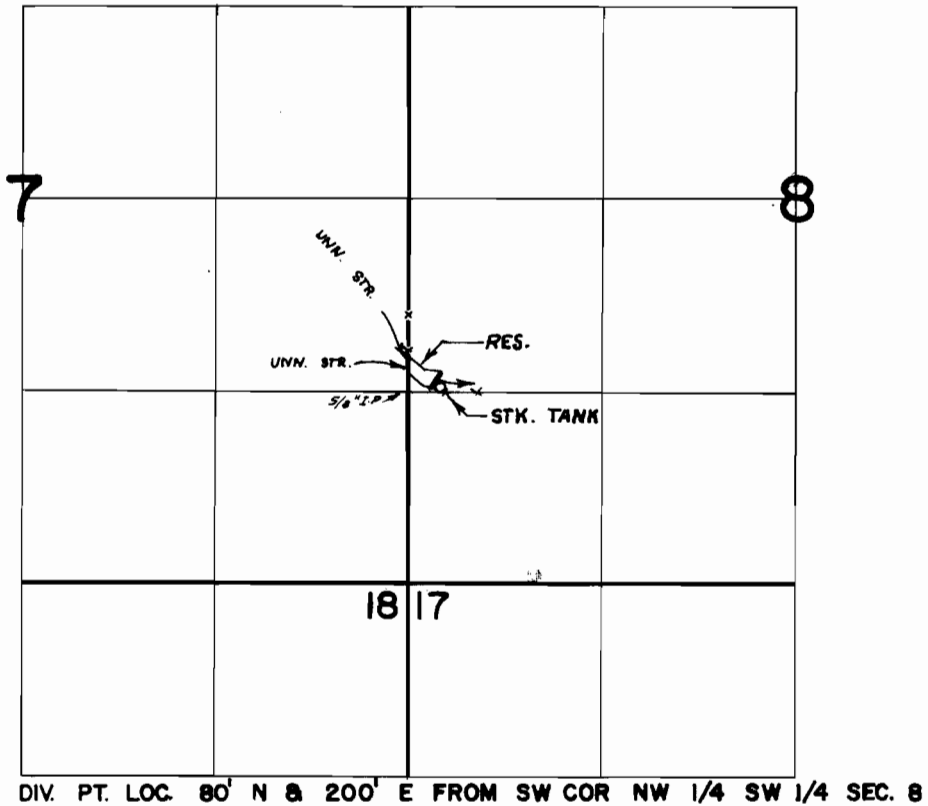

FINAL PROOF SURVEY UNDER

Application No. ^{R-43926} 44400 Permit No. ^{R-4945} 33164
IN NAME OF

.....WILLIAM E. MENTZE.....

Surveyed AUG. 18, 1971, by R. MUCKEN.....