


# T. 18 S. R. 4 W. W. M.

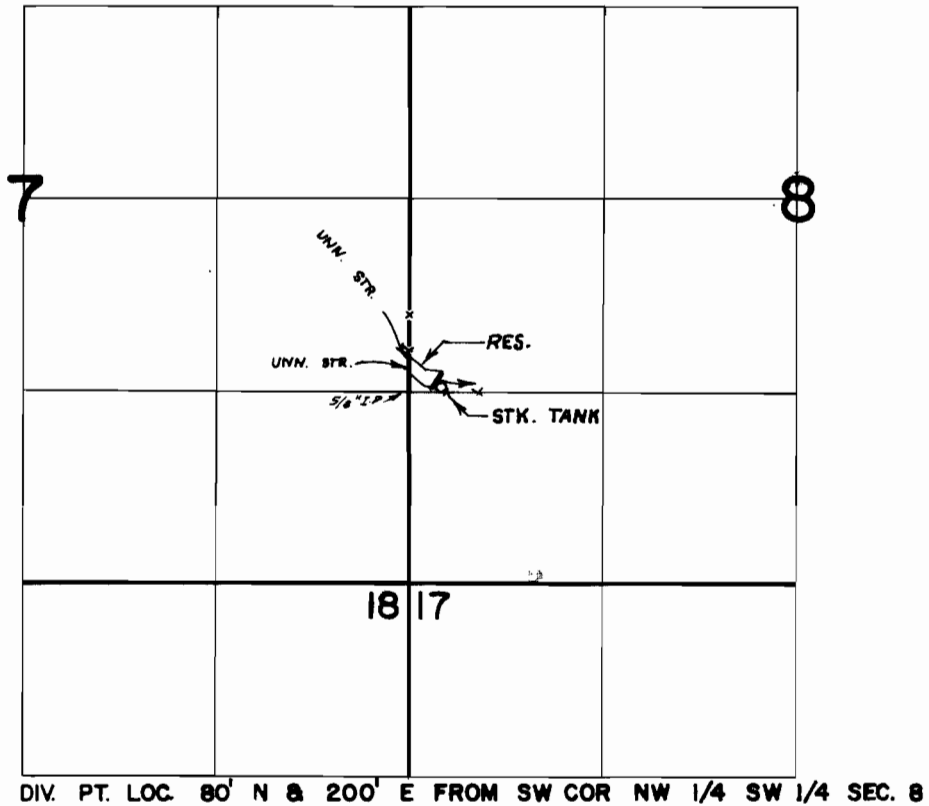

## FINAL PROOF SURVEY UNDER

Application No. <sup>R-43926</sup> 44400 Permit No. <sup>R-4945</sup> 33164  
IN NAME OF

.....WILLIAM E. MENTZE.....

Surveyed AUG. 18, 1971, by R. MUCKEN.....