


# T. 4 S. R. 1 W. W. M.

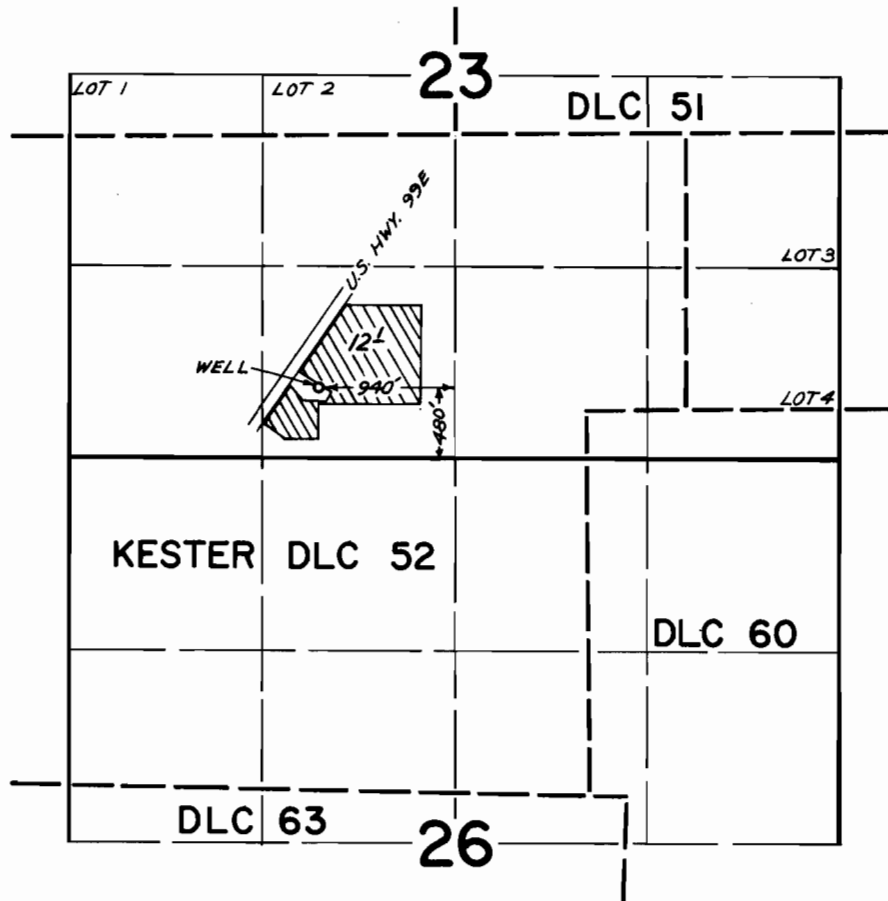

## FINAL PROOF SURVEY UNDER

Application No. G-3456 Permit No. G-3262  
IN NAME OF

STEVE PICCARDO

Surveyed MAY 21, 1971, by GREG BACA