


T. 7 & 8 S. R. 2 W. W. M.

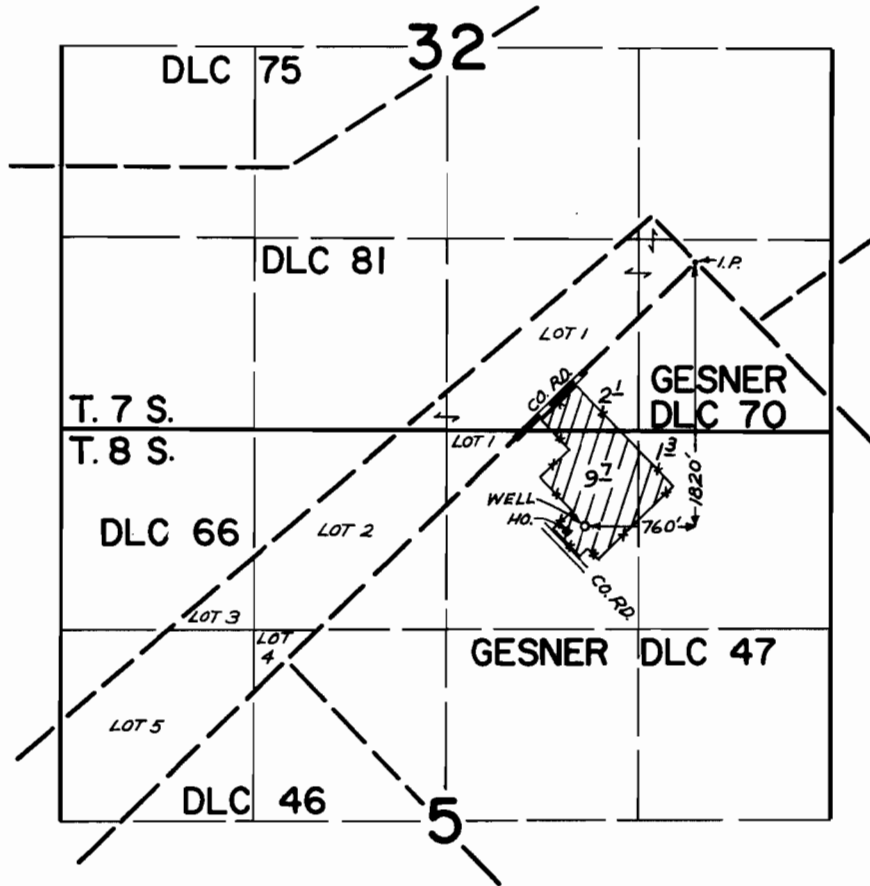

FINAL PROOF SURVEY
UNDER

Application No. G-3595 Permit No. G-3382
IN NAME OF

ROBBIE FISHER

Surveyed APR. 30 1971, by GREG BACA