


T. 7 S. R. 2 W. W. M.

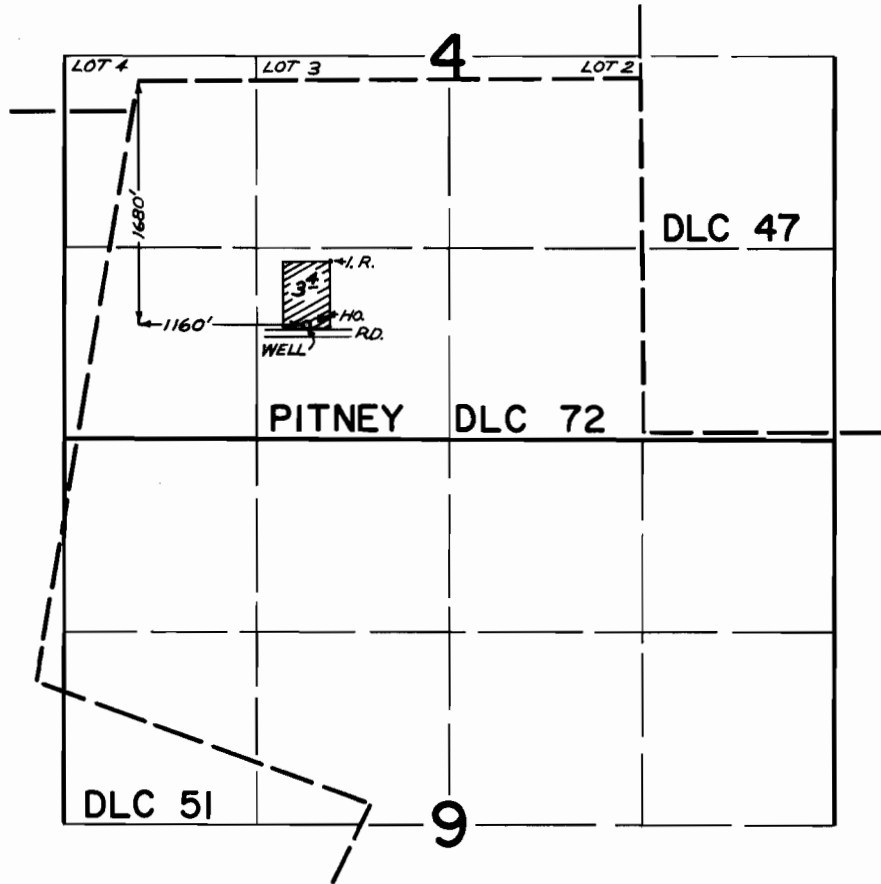

**FINAL PROOF SURVEY**  
UNDER

Application No. G-4032 Permit No. G-3762  
IN NAME OF

ROY W. FISKE

Surveyed MAY 18 1971, by GREG BACA