


T. 6 S. R. 2 W. W. M.

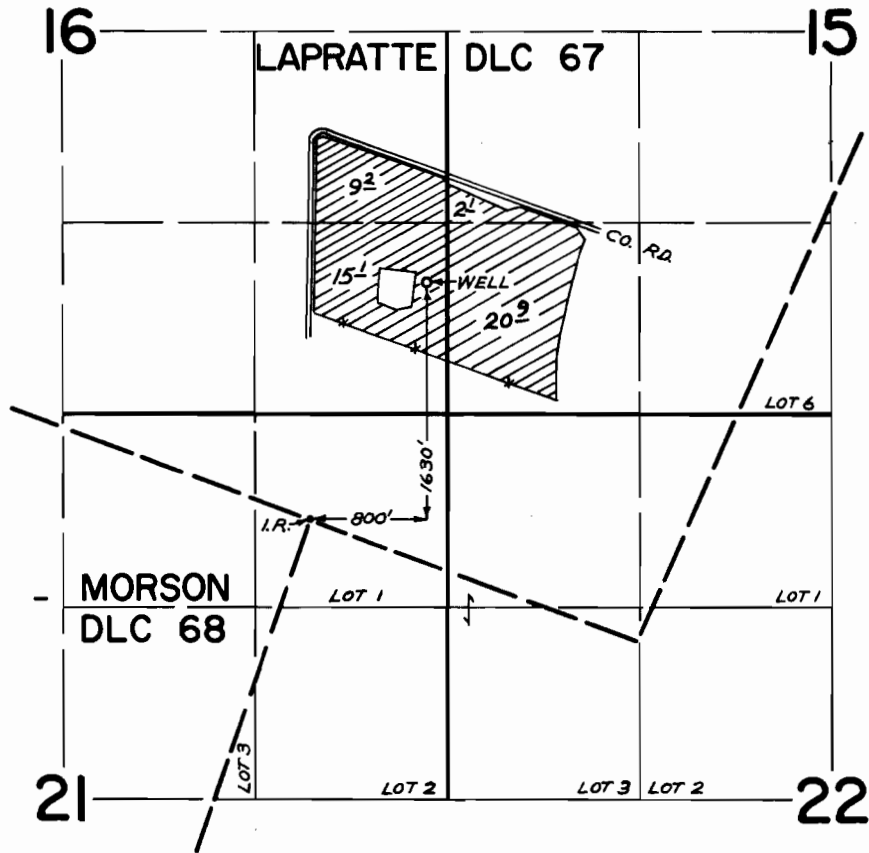

FINAL PROOF SURVEY
UNDER

Application No. G-4060 Permit No. G-3806
IN NAME OF

WALTER H. RENNICK

Surveyed MAY 18 1971, by GREG BACA