


T. 6 S. R. 1 E. W. M.

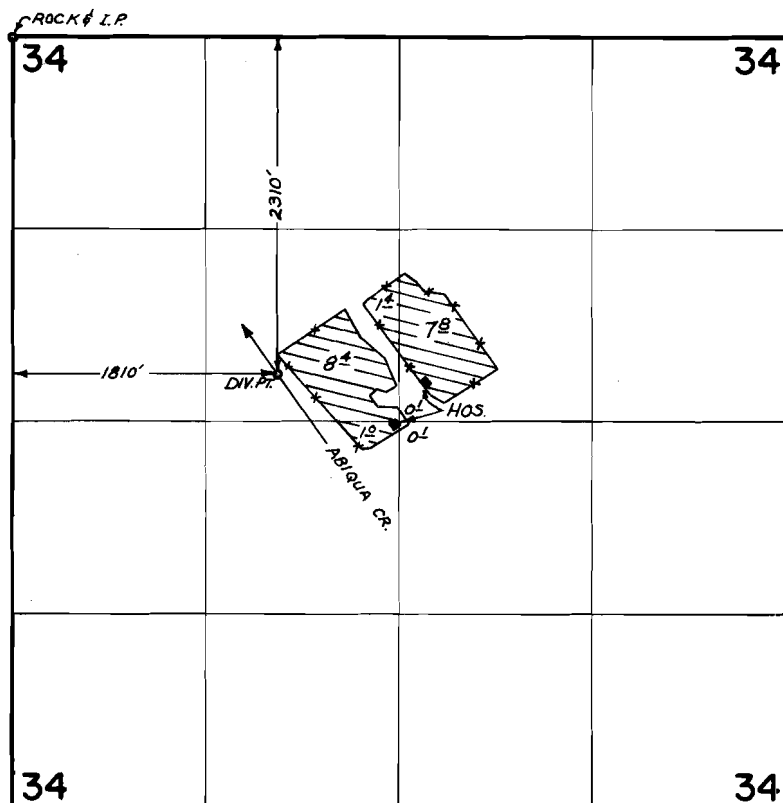

FINAL PROOF SURVEY UNDER

Application No. 39974 Permit No. 29744
IN NAME OF

CURRAN MOORE

Surveyed APR. 27 1971, by GREG BACA