


# T. 8 S. R. 3 W. W. M.

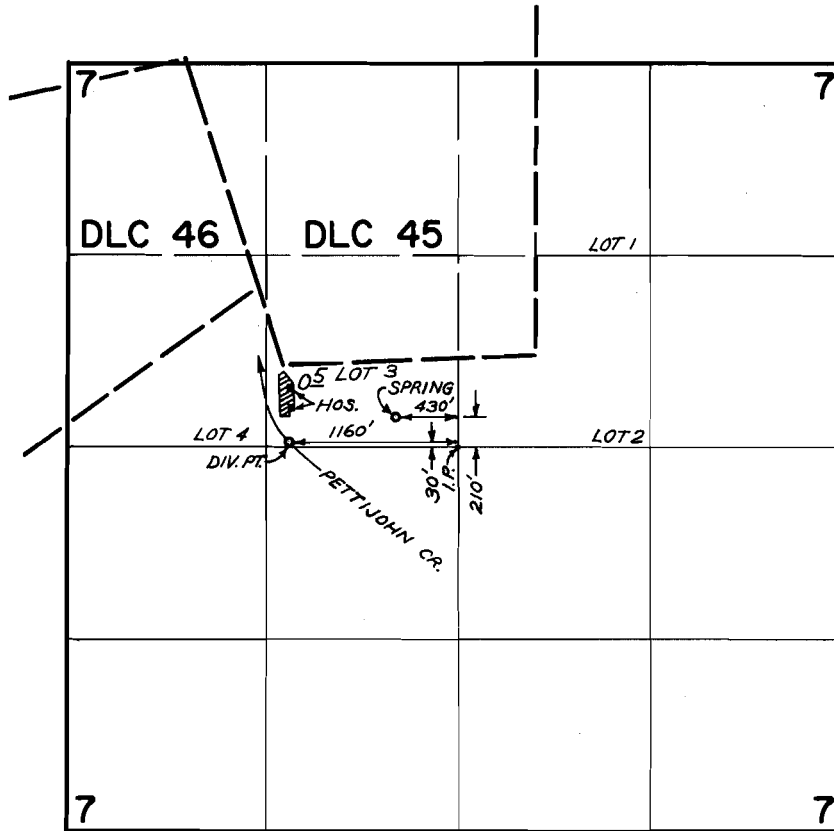

## FINAL PROOF SURVEY UNDER

Application No. 40215..... Permit No. 29995.....  
IN NAME OF

CLINTON G. & VIRGINIA R. LAMMERS

Surveyed APR. 28 1971., by GREG BACA.....