


T. 5 S. R. 1 W. W. M.

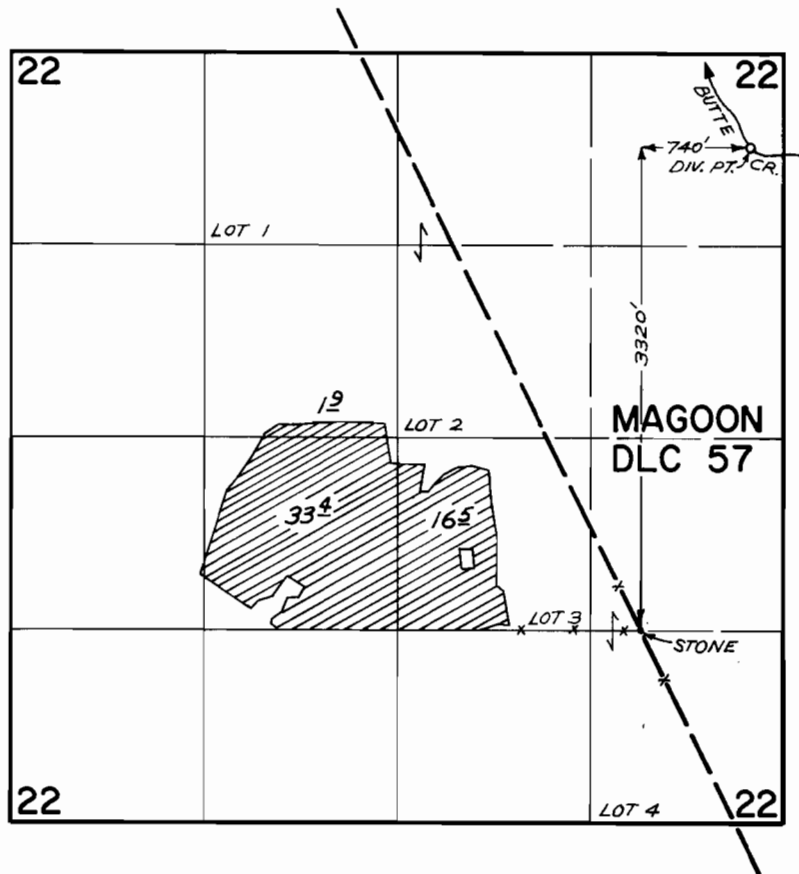

FINAL PROOF SURVEY UNDER

Application No. 41526 Permit No. 30983
IN NAME OF

ELIZABETH HITZ

Surveyed MAY 21 1971, by GREG BACA