


T. 4 S. R. 2 W. W. M.

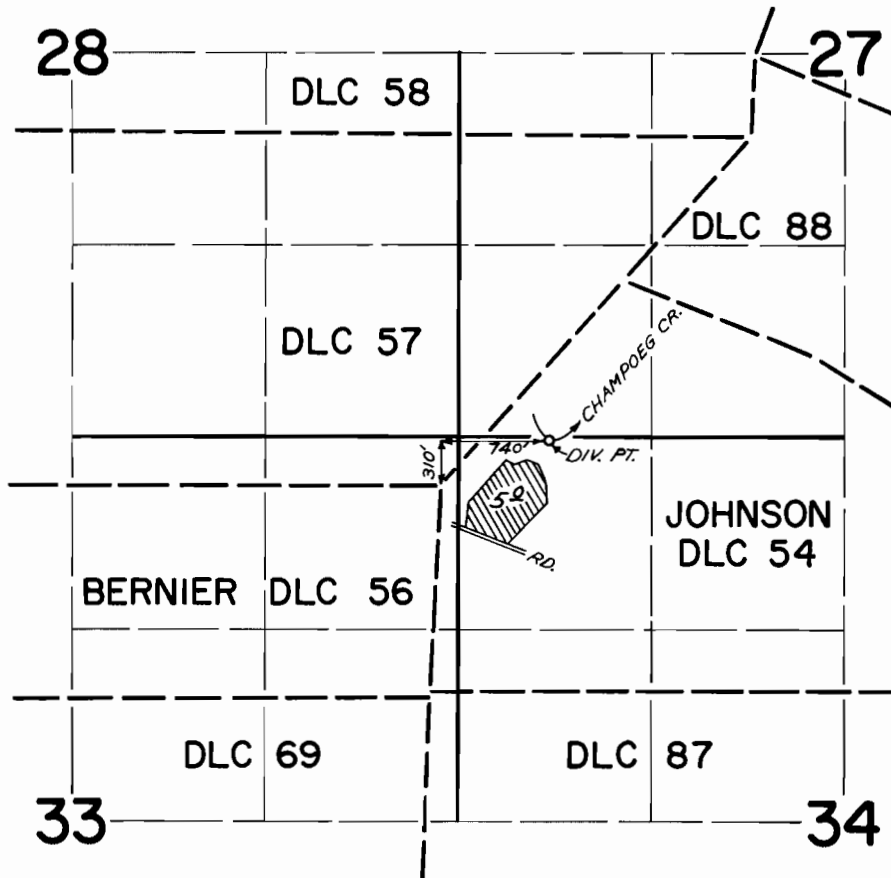

FINAL PROOF SURVEY
UNDER

Application No. 43333 Permit No. 32390
IN NAME OF

FRANCIS W. BENSON

Surveyed JULY 13 1971, by GREG BACA