


T 5 N. R. 27 E. W. M.

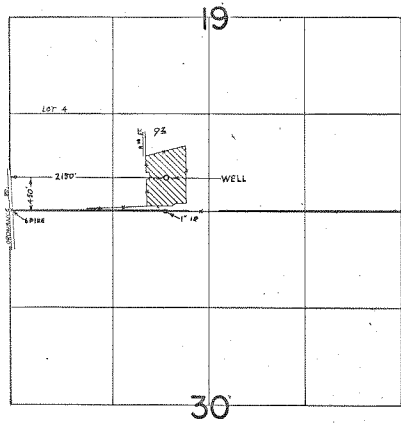

FINAL PROOF SURVEY UNDER

Application No. G-4586. Permit No. G-4257.
IN NAME OF

..... FRED WALKER

Surveyed JULY 2, 1921, by R. MUCKEN.....