


T.38&4S.R.25E.W.M.

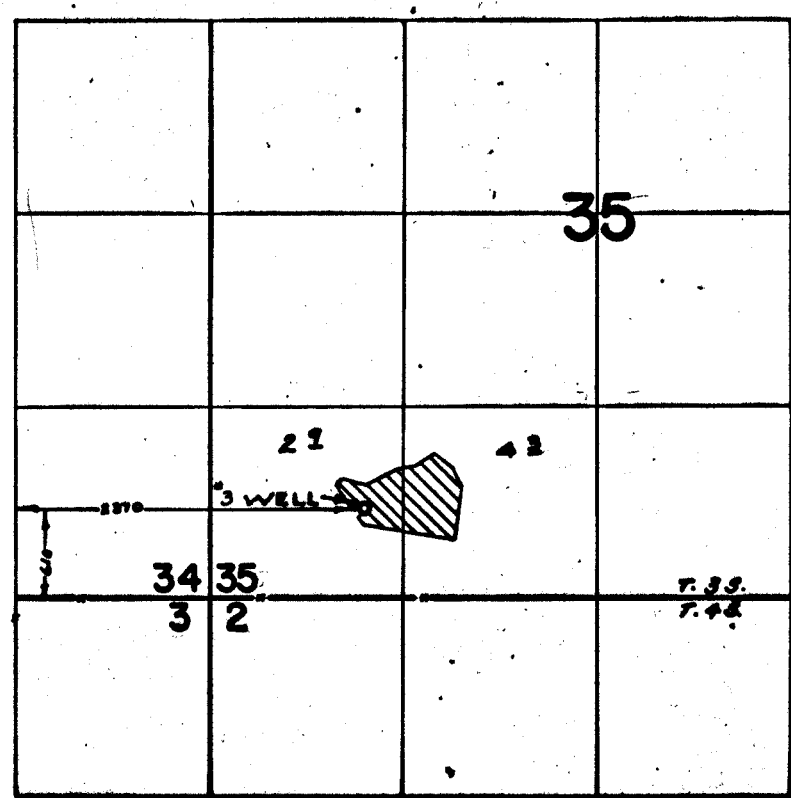

FINAL PROOF SURVEY UNDER

Application No. 2-4666 Permit No. G-4920
IN NAME OF

HAROLD A. WRIGHT

Surveyed Mar. 11, 1971, by R. MICKEL