G-9388

G-9411 38587

38589

T.3S.R.25E.W.M.

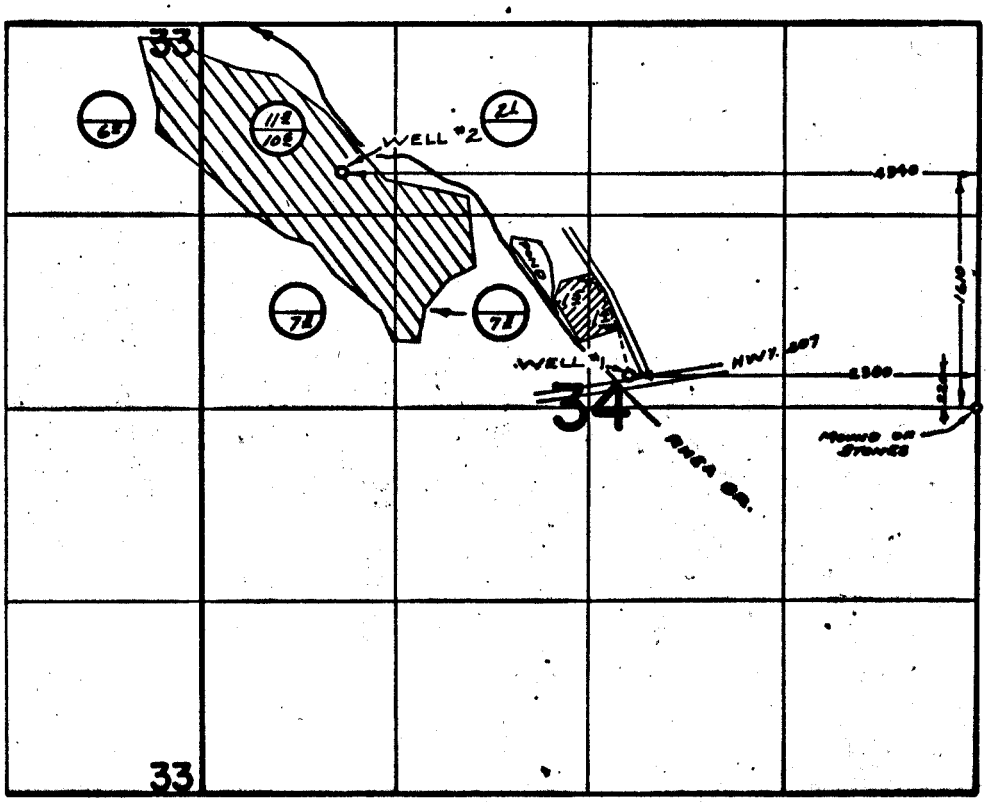

FINAL PROOF SURVEY
UNDER

Application No. G-4663 G-4690 Permit No. G-4307 G-4411

IN NAME OF

HAROLD A. WRIGHT

Surveyed May 11, 19 71, by R. MUCKAM