


T. 2 S. R. 26 E. W. M

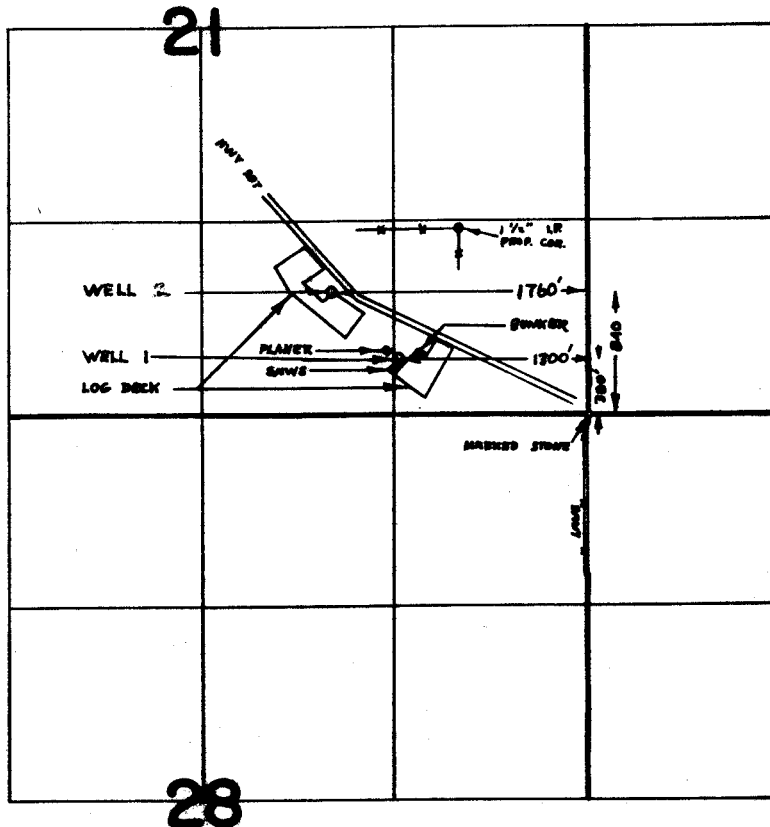

FINAL PROOF SURVEY UNDER

Application No. G-4909 Permit No. G-4626
IN NAME OF
J. B. MALCOM CO., INC. dba.
HEPPNER LUMBER COMPANY

Surveyed MAY 6, 1971, by R. MUCKEN