


T.I.S.R.25E.W.M.

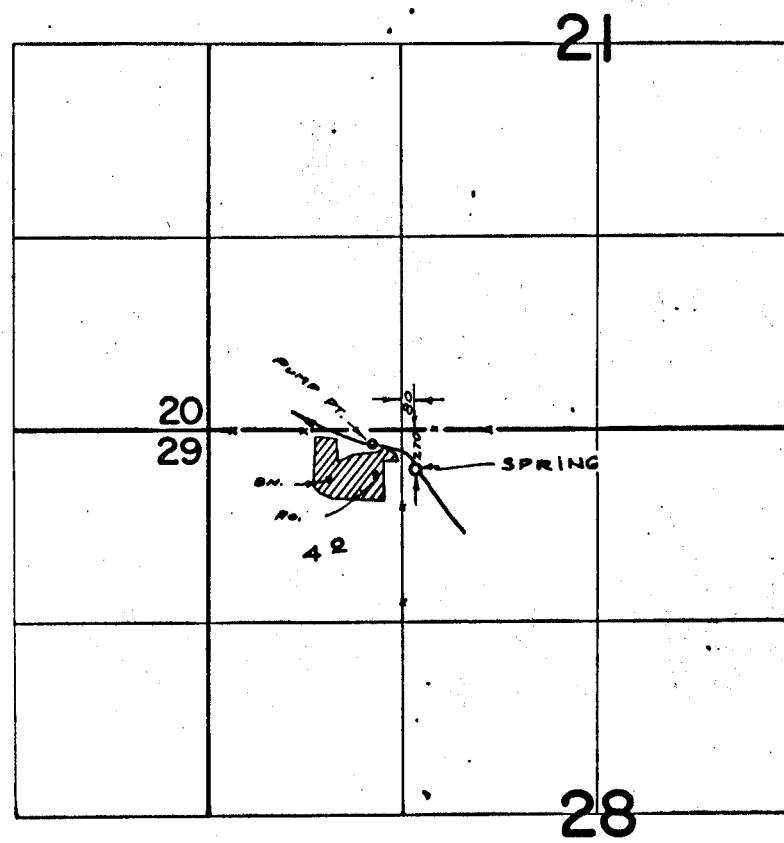

FINAL PROOF SURVEY
UNDER

Application No. 45817..... Permit No. 34189
IN NAME OF

ROBERT HARRISON

Surveyed Max 14, 1971., by R. MUGGEN