


# T. 4 S. R. 10 W. W. M.

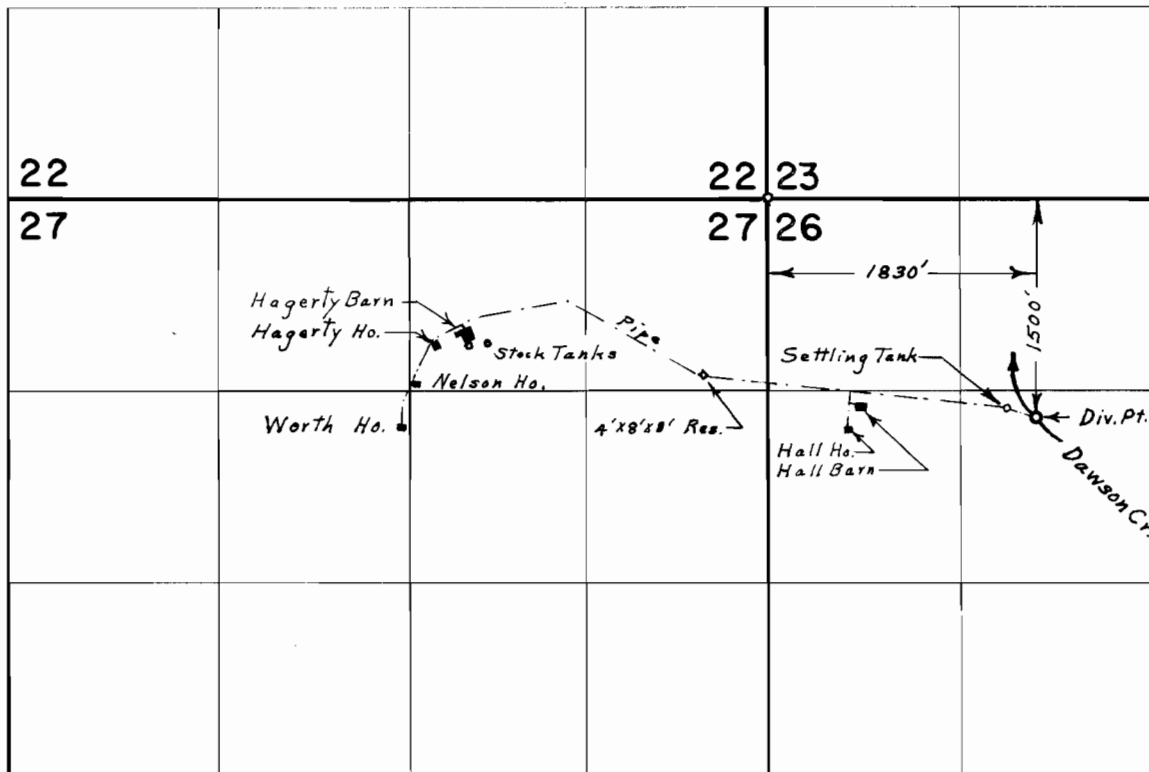

## FINAL PROOF SURVEY UNDER

Application No. 42393 Permit No. 31737  
IN NAME OF

**JOHN E., BRUCE E., & WILMA D. HAGERTY**

Surveyed Aug. 13, 1971, by L. E. Gould.