


# T. 1 N. & 1 S. R. 9 W. W.M.

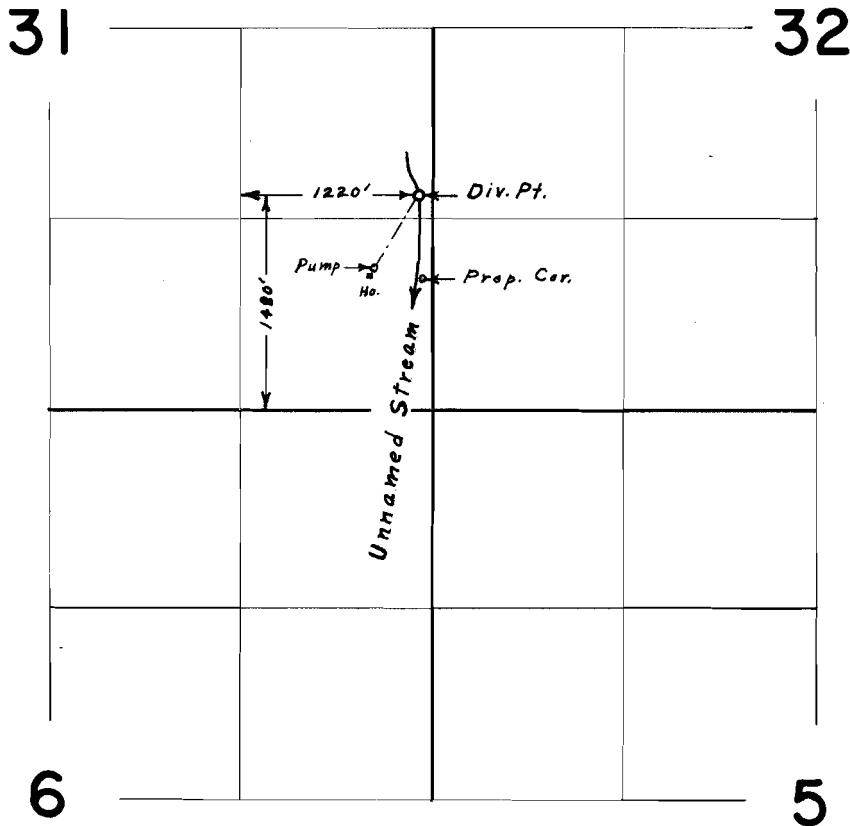

## FINAL PROOF SURVEY UNDER

Application No. 43489 Permit No. 32528  
IN NAME OF

NEIL ALFRED MAGNUSON

Surveyed June 10, 1971, by L. E. Gould