


T. 4 S. R. 10 W. W. M.:

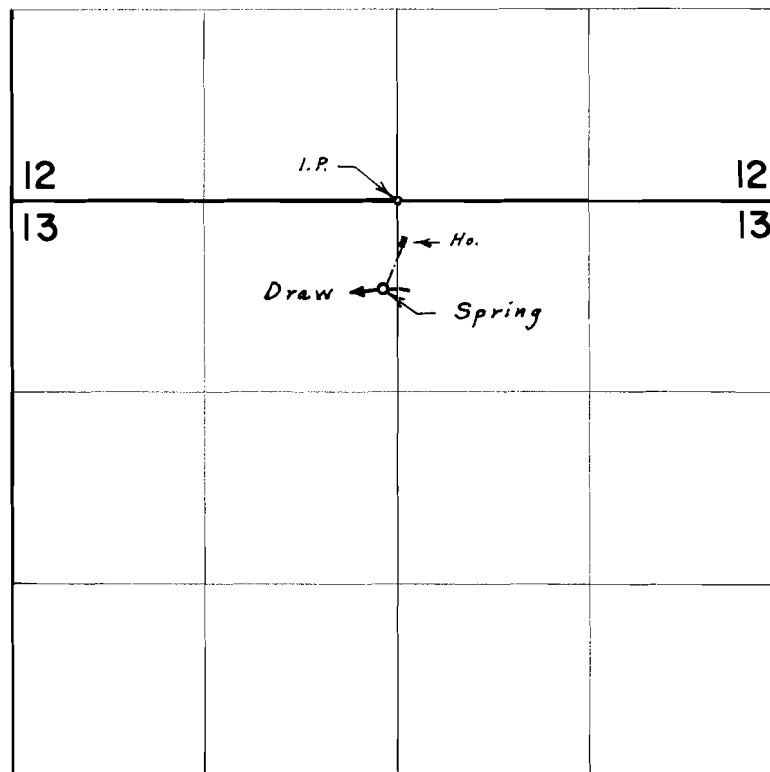

Spring located 610' S. & 100' W. N. $\frac{1}{4}$ Cor. Sec. 13

FINAL PROOF SURVEY
UNDER

Application No. 46184 Permit No. 34511
IN NAME OF

WALLACE L. NELSON

Surveyed Aug. 9, 1971, by L. E. Gould