


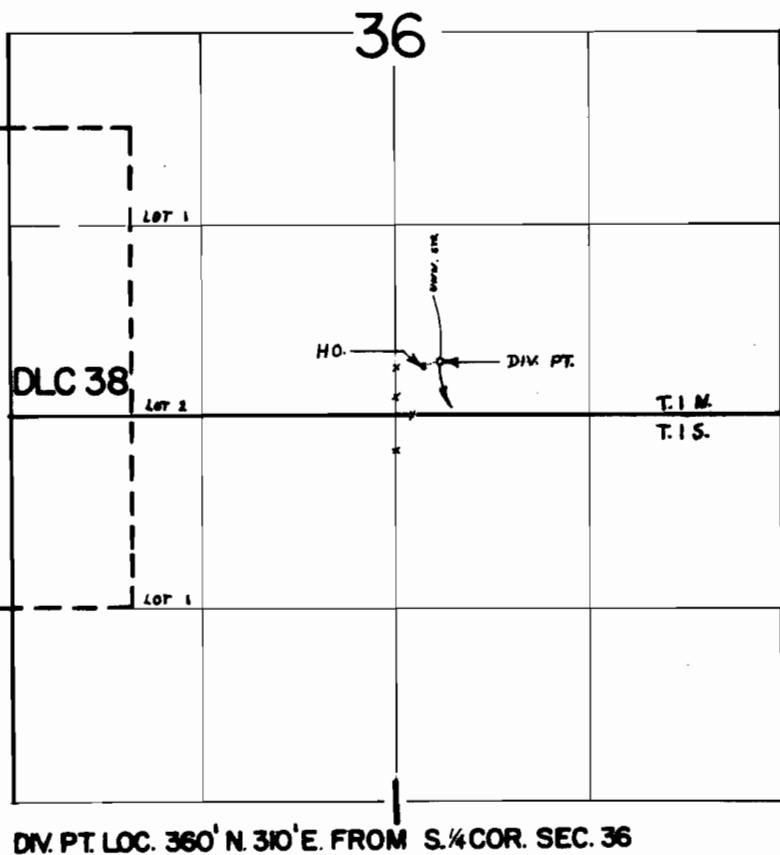

FINAL PROOF SURVEY

UNDER

Application No. 46653 Permit No. 34857
IN NAME OF

JOHANNA M. CASTLE

Surveyed AUG. 3, 1971, by R. MUCKEN