


# 31064

THE DALLES DAM  
COLUMBIA RIVER  
DIV. PT.  
LOT 23

# T. 1 & 2 N. R. 14 E. W. M.

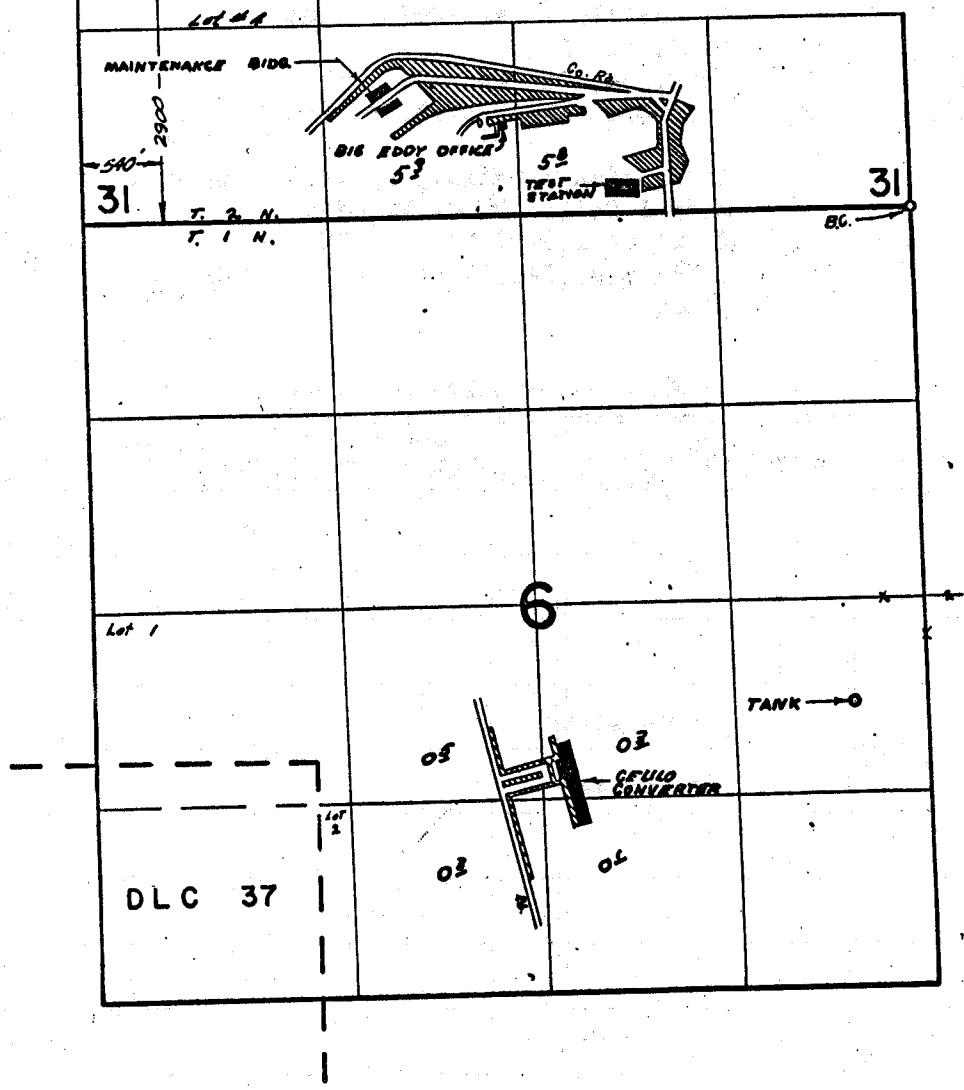

## FINAL PROOF SURVEY

UNDER

Application No. 41615..... Permit No. 31064....

IN NAME OF  
U. S. DEPARTMENT OF THE INTERIOR  
BONNEVILLE POWER ADMINISTRATION

Surveyed NOV. 12, 1971, by L. E. Gould.....