


32460

T.4S.R.12E.W.M.

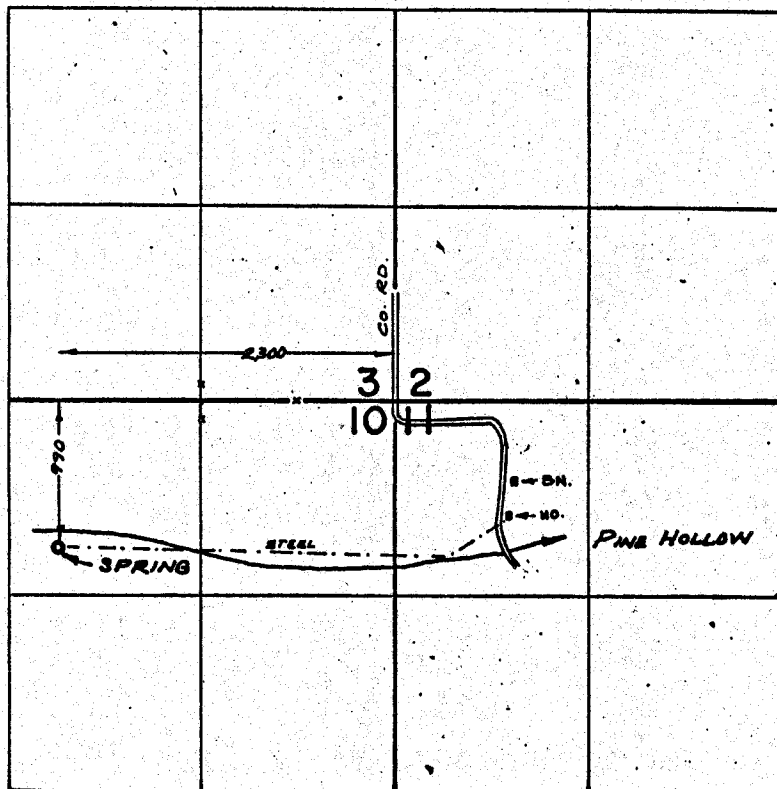

FINAL PROOF SURVEY UNDER

Application No. 43416... Permit No. 32460...
IN NAME OF

..... VERNON L. WING

Surveyed Nov. 8, 1971, by R. MUCKEN