


4929
3860

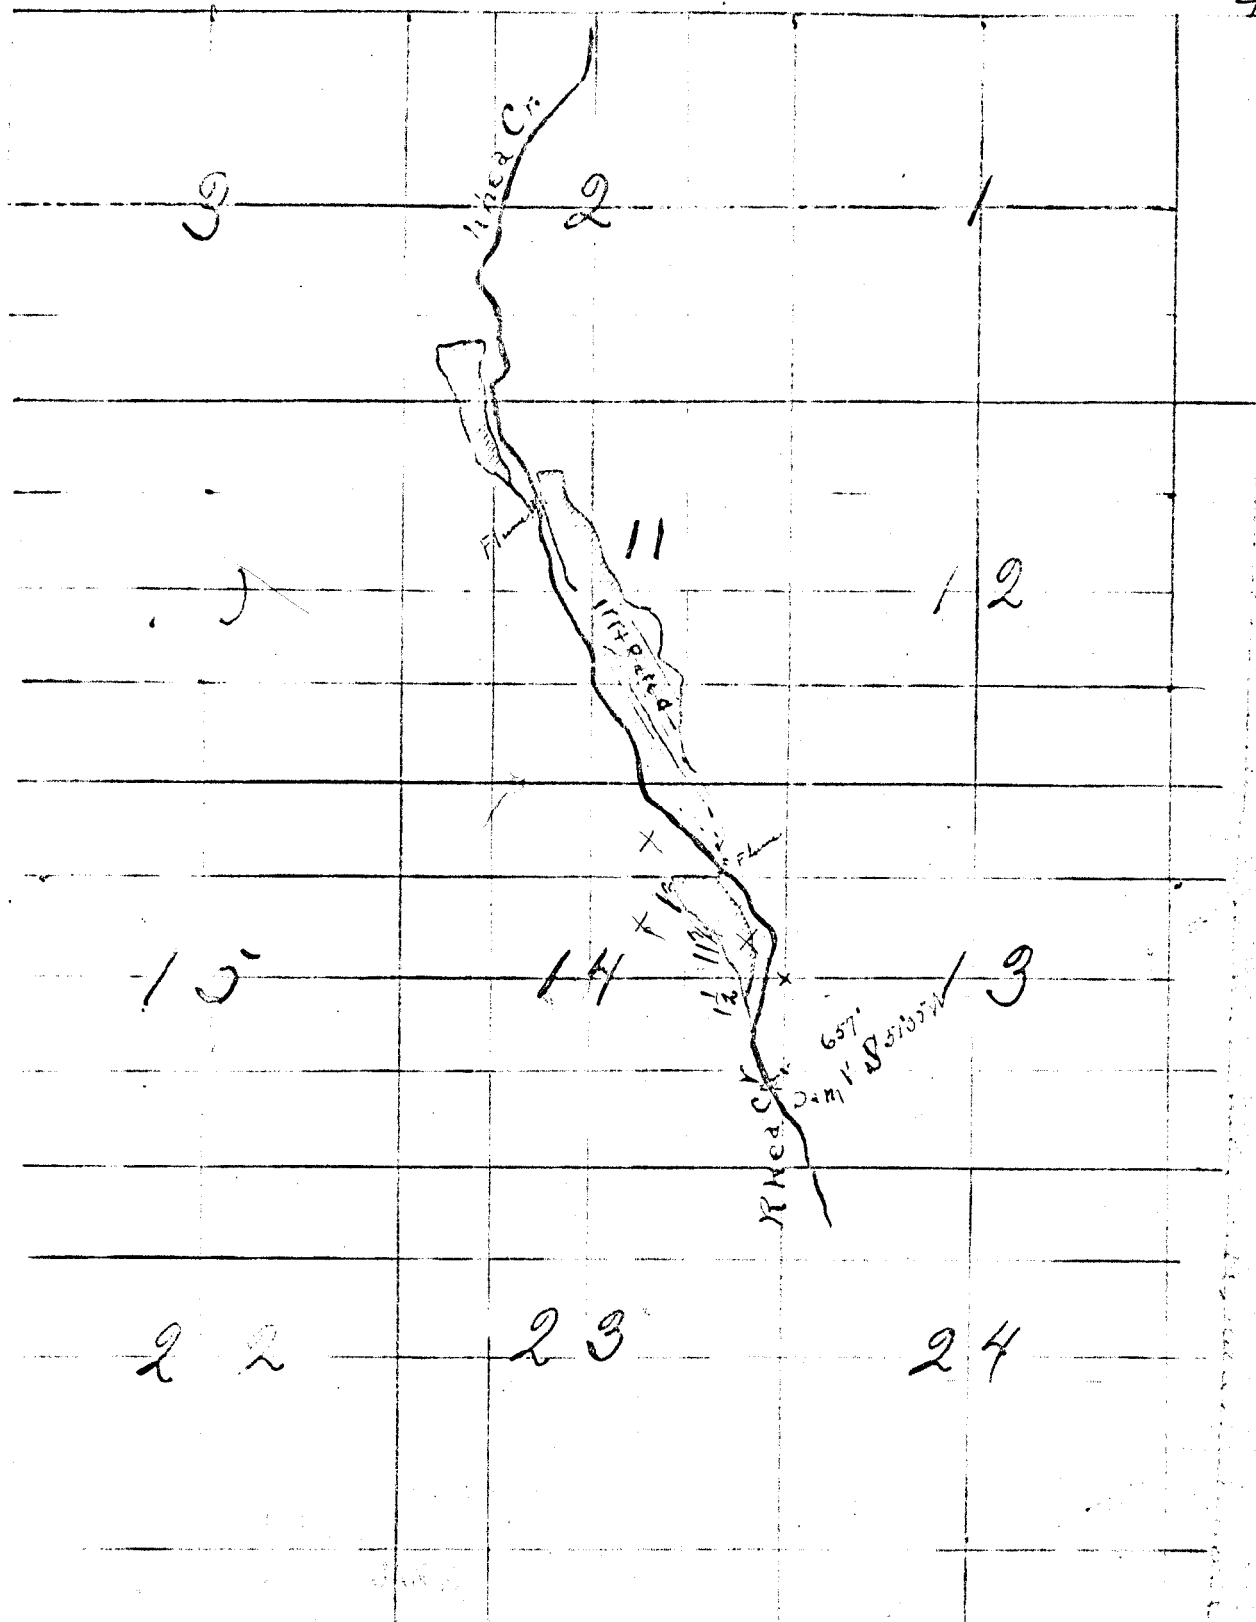

Application No. 7129
Permit No. 4929

I, L. A. Hunt, of McPPner, Ore.
do hereby certify that this map was made
from notes made during an actual survey made by
me Oct. 20, 1920 and that it correctly represents