


T. 1 N. R. 4 W. W. M.

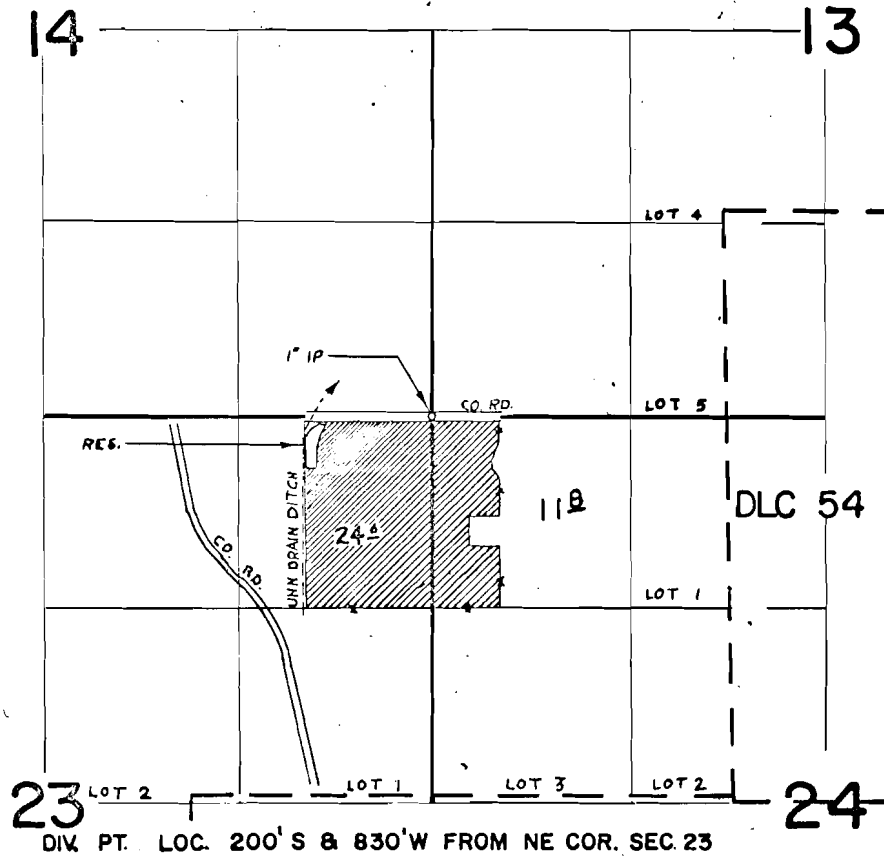

FINAL PROOF SURVEY UNDER

Application No. R-41532 41533 Permit No. R-4657 30844
IN NAME OF

VERNON E. DUYCK

Surveyed JUNE 17, 1971, by R. MUCKEN