


T. 1 N. R. 3 & 4 W. W. M.

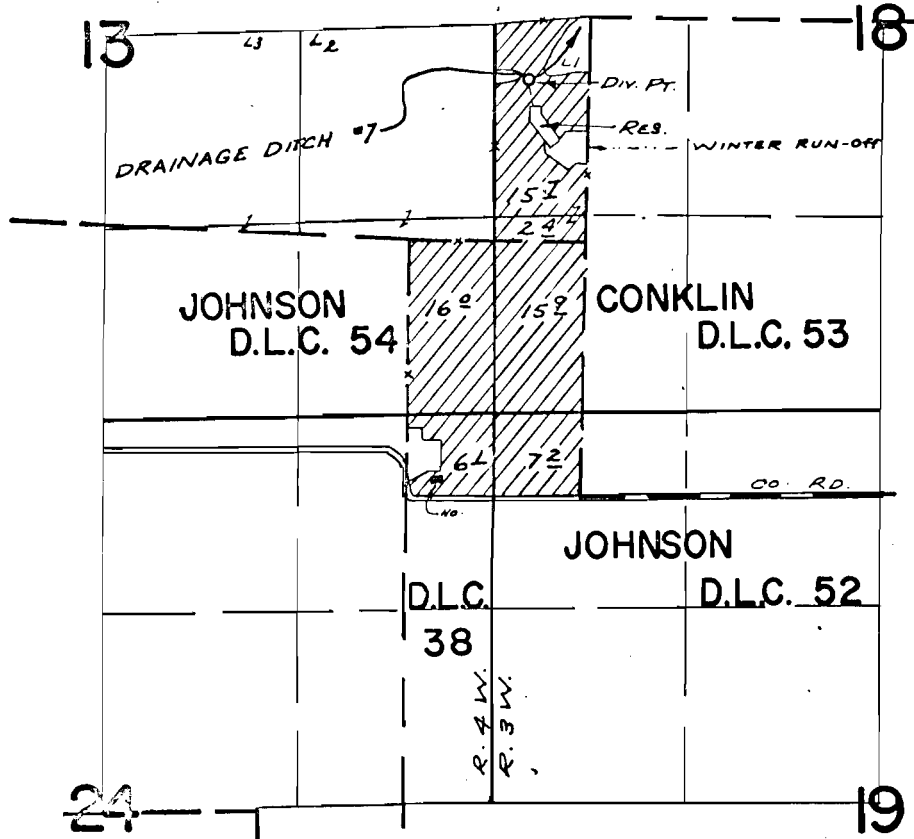

DIV. PTS. LOC: DRAIN #7-1080' N. & 810' E; RES. - 760' N. & 900' E. BOTH FROM N.E. COR. D.L.C. 54

FINAL PROOF SURVEY UNDER

Application No. R-42969 Permit No. R-4883
IN NAME OF

VERNON DUYCK

Surveyed APR. 20, 1971. by R. MUCKEN