T. 1 N. R. 3 W. W.M.

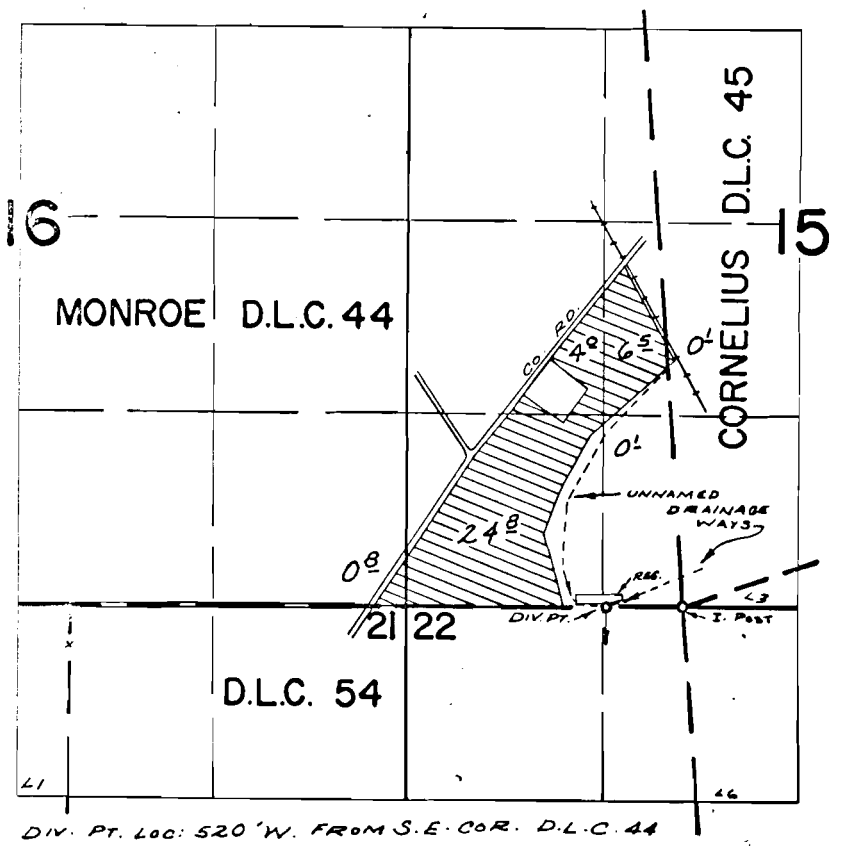

FINAL PROOF SURVEY

UNDER

Application No. R-42706 42707 Permit No. R-4858 31946

IN NAME OF

JACK DELPLANCHE

Surveyed APR. 22, 1971, by R. MUCKEN.

1971-J