


T. 1 & 2 N. R. 3 W. W. M.

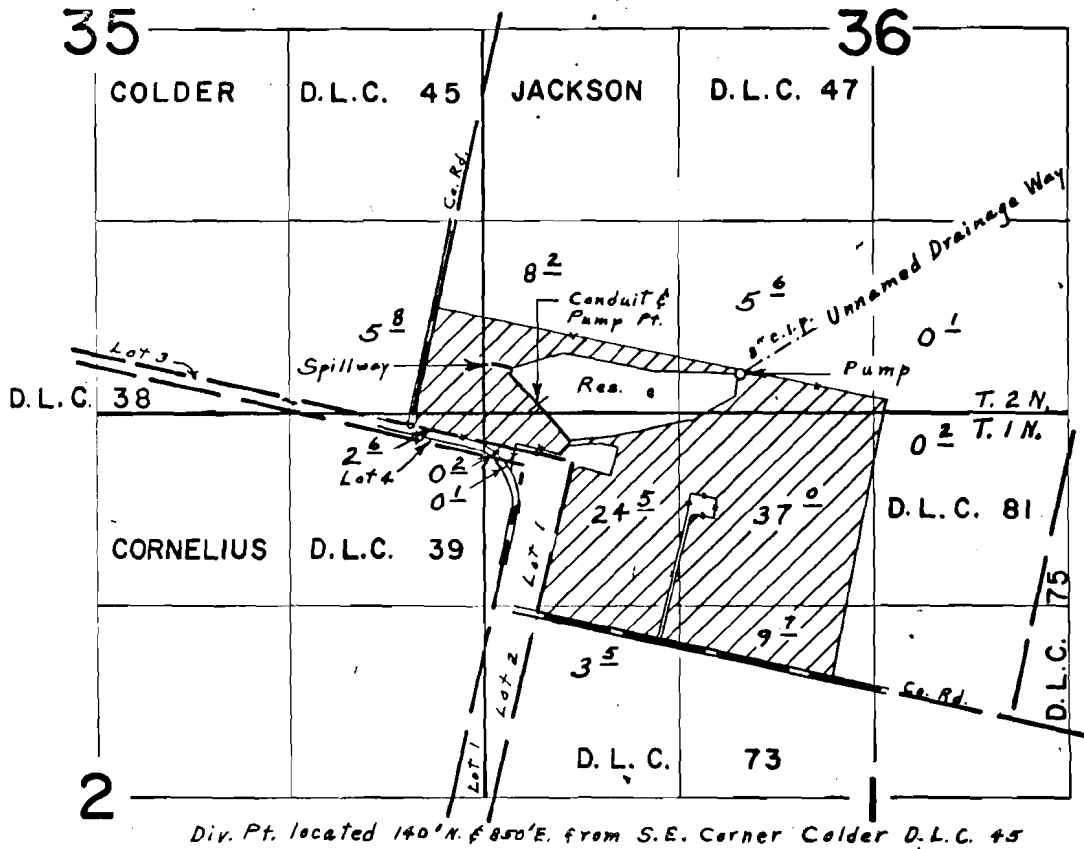

FINAL PROOF SURVEY UNDER

R-43619 R-4913
Application No. 43620 Permit No. 32205

IN NAME OF

HILL A. LIND

Surveyed May 25, 1971, by L. E. Gould