


T. 1 S. R. 3 W. W. M.

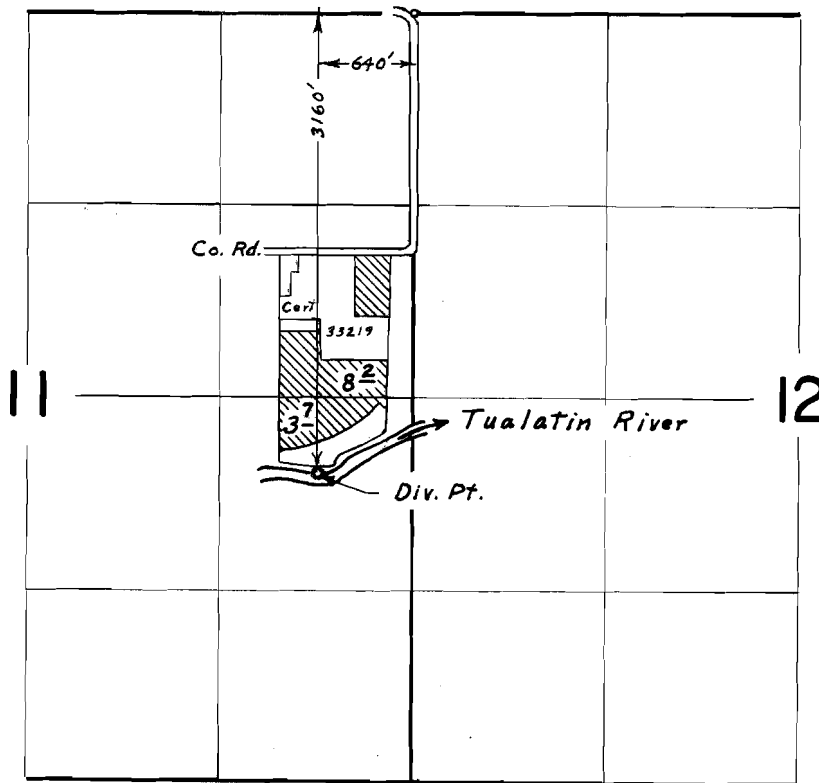

FINAL PROOF SURVEY
UNDER

Application No. 40649 Permit No. 30281
IN NAME OF

WESLEY BRYAN

Surveyed April 21, 1971, by L. E. Gould.