


T. 1 S. R. 3 W. W. M.

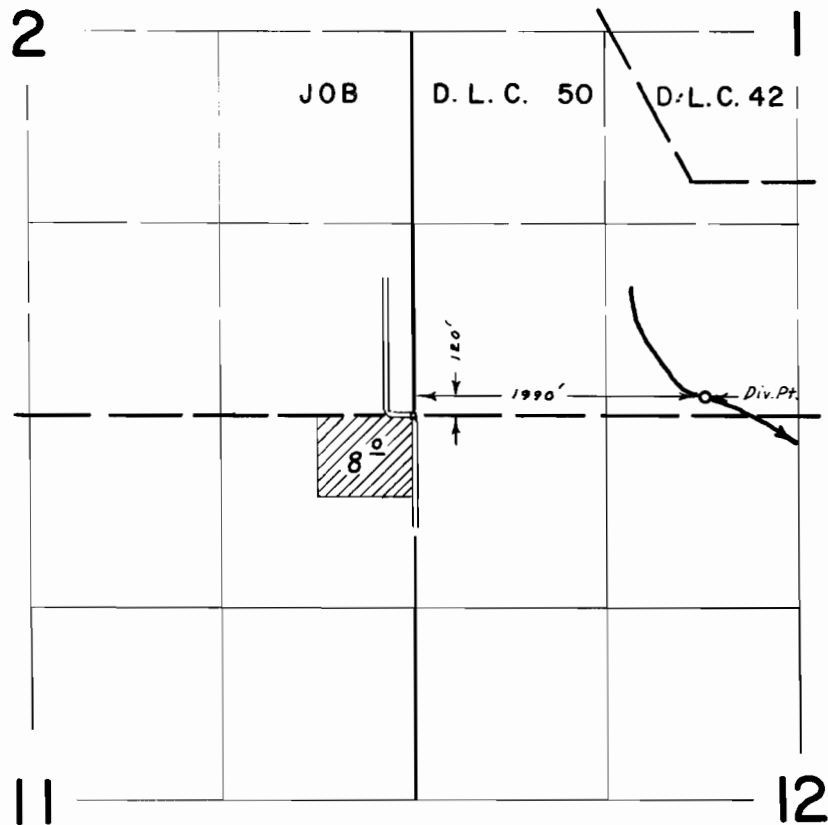

FINAL PROOF SURVEY UNDER

Application No. 41578 Permit No. 31013
IN NAME OF

EDMUND H. & GERTRUDE A. DUYCK

Surveyed April 21, 1971, by L. E. Gould