


T. 3 S. R. 2 W. W. M.

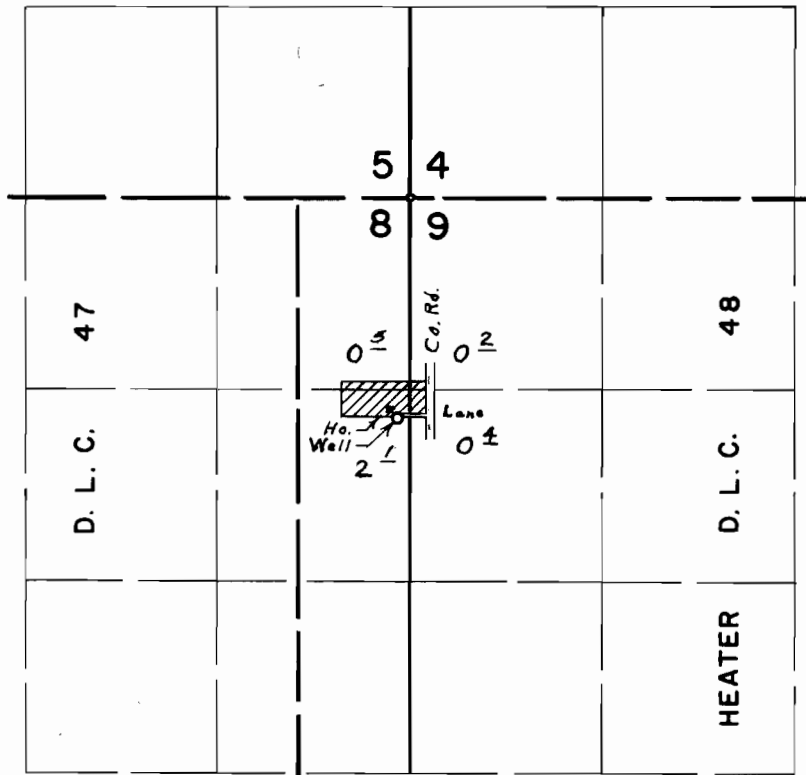

Well located 1520' S. & 80' W. from N.E. Cor. Sec. 8

FINAL PROOF SURVEY UNDER

Application No. G-3446 Permit No. G-3227
IN NAME OF

WALTER E. KOVACH

Surveyed July 28, 1971, by L. E. Gould