


T. 2 S. R. 5 W. W.M.

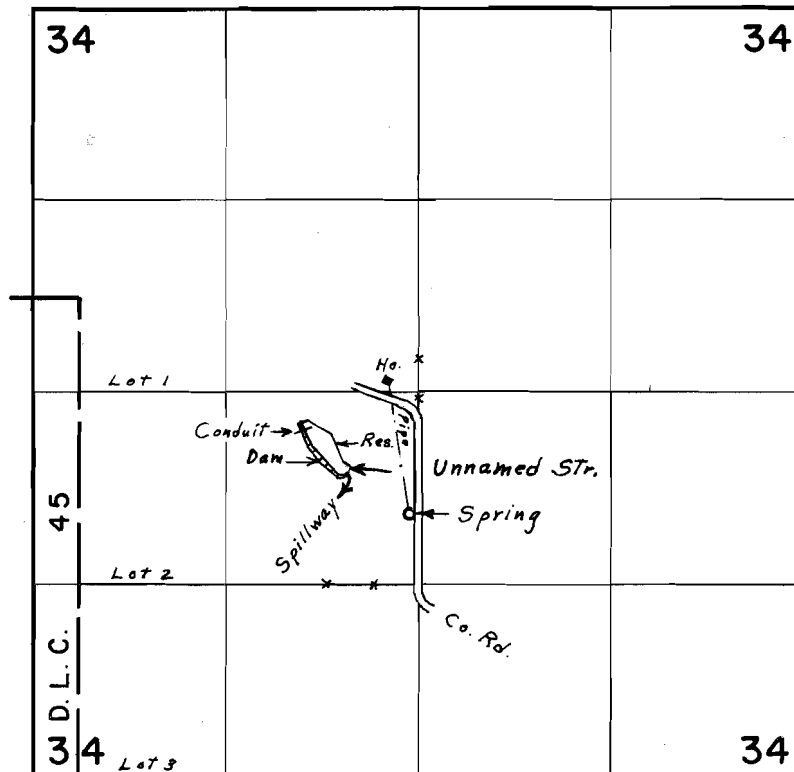

Div. Pts. located: Spr. 480' N. & 60' W.; Res., 760' N. &
480' W.; both from S.E. Cor. N.E. $\frac{1}{4}$ S.W. $\frac{1}{4}$ Sec. 34

FINAL PROOF SURVEY
UNDER

R-40337 R-4510
Application No. 40123 Permit No. 30045
IN NAME OF

WALTER TUREK

Surveyed June 4, 1971, by L. E. Gould