


T. 3 S. R. 3 W. W. M.

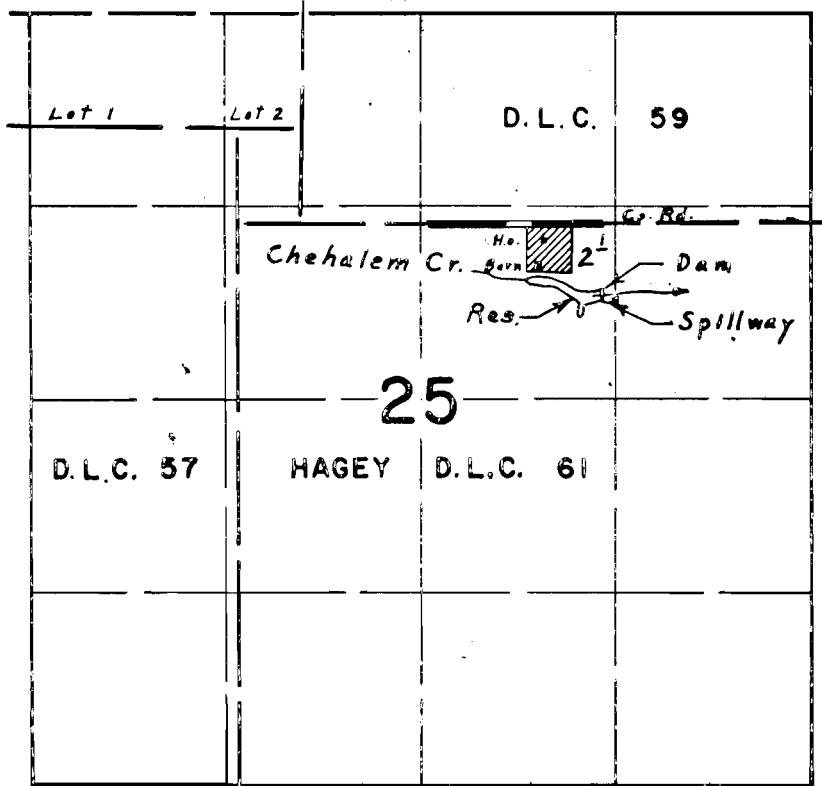

Div. Pt. located 490' S. & 2460' E. from N.W. Cor. Hagey D.L.C. 61

FINAL PROOF SURVEY UNDER

R-40715 R-4559
Application No. 40716 Permit No. 30329
IN NAME OF

GEORGE W. & DORIS B. PORTER

Surveyed Sept. 9, 1971, by L. E. Gould