


T. 2 S. R. 5 W. W. M.


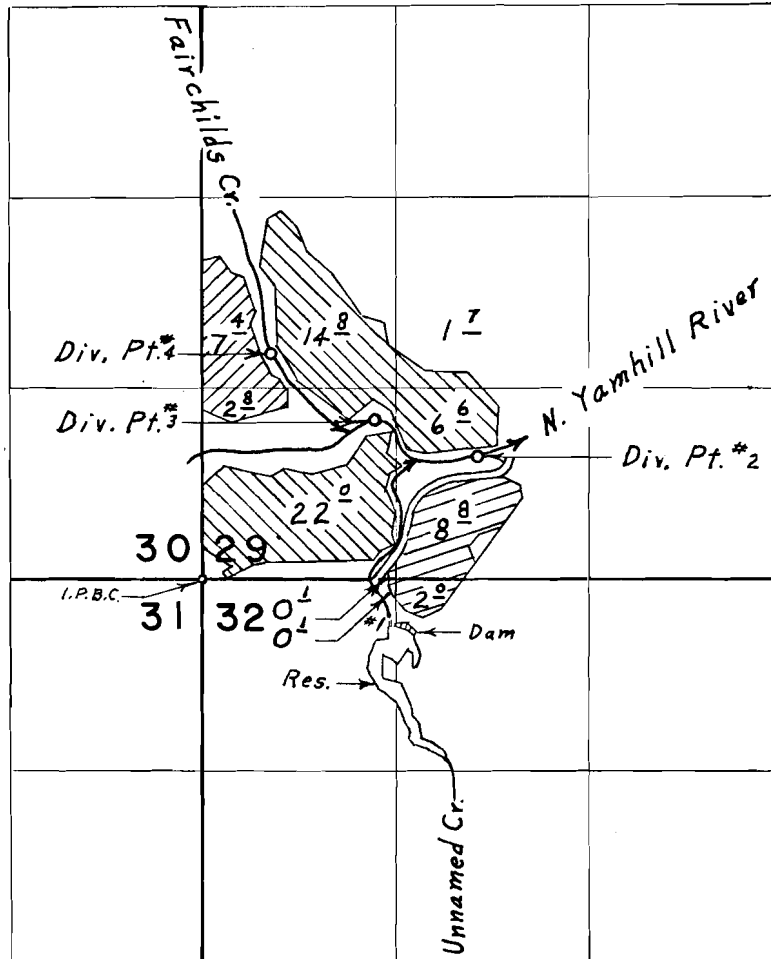


Div. Pts. located: #1, 320' S. & 1280' E.; #2, 850' N. & 1880' E.; #3, 1100' N. & 1180' E.; #4, 1560' N. & 470' E. all from S.W. Cor. Sec. 29

Div. Pt. #1

Div. Pts. #2 & 3

Div. Pt. #4

  

# FINAL PROOF SURVEY UNDER

R-40915 R-4586  
Application No. 40916 Permit No. 30492.  
IN NAME OF

BRICE G. & BARBARA J. MITCHELL

Surveyed July 9, 1971, by L. E. Gould.