


T. 2 S. R. 5 W. W. M.

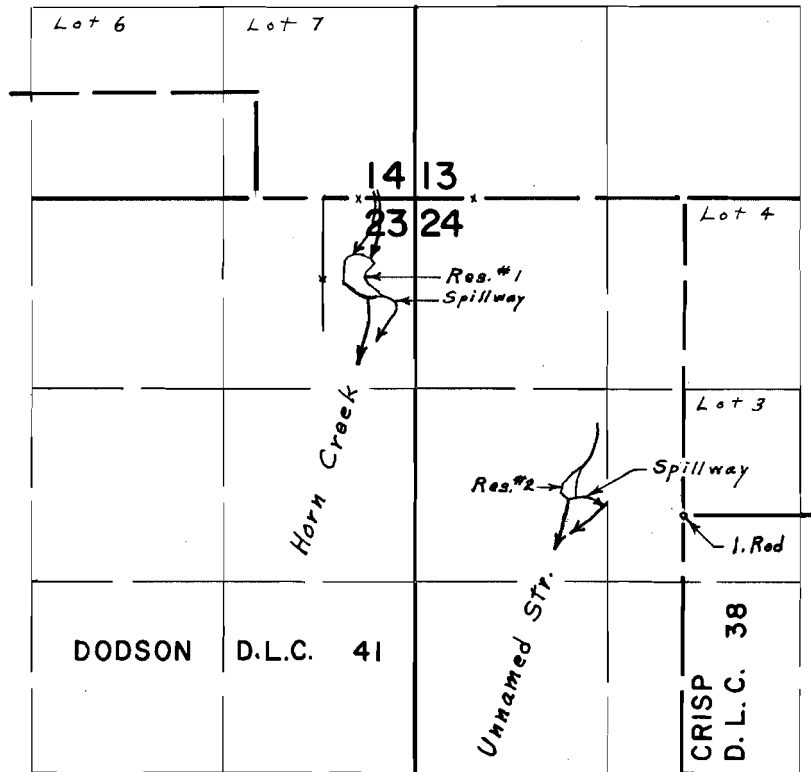

Div. Pts. located: Res. #1, 1500' N. & 2170' W.; Res. #2, 120' N. & 790' W., both From N. W. Corner Crisp D. L. C. 38

FINAL PROOF SURVEY
UNDER

R-43302 R-4969
Application No. 43642 Permit No. 32421
IN NAME OF

ALAN SANDLER

Surveyed June 4, 1971, by L. E. Gould