


T. 3 S. R. 2 & 3 W. W. M.

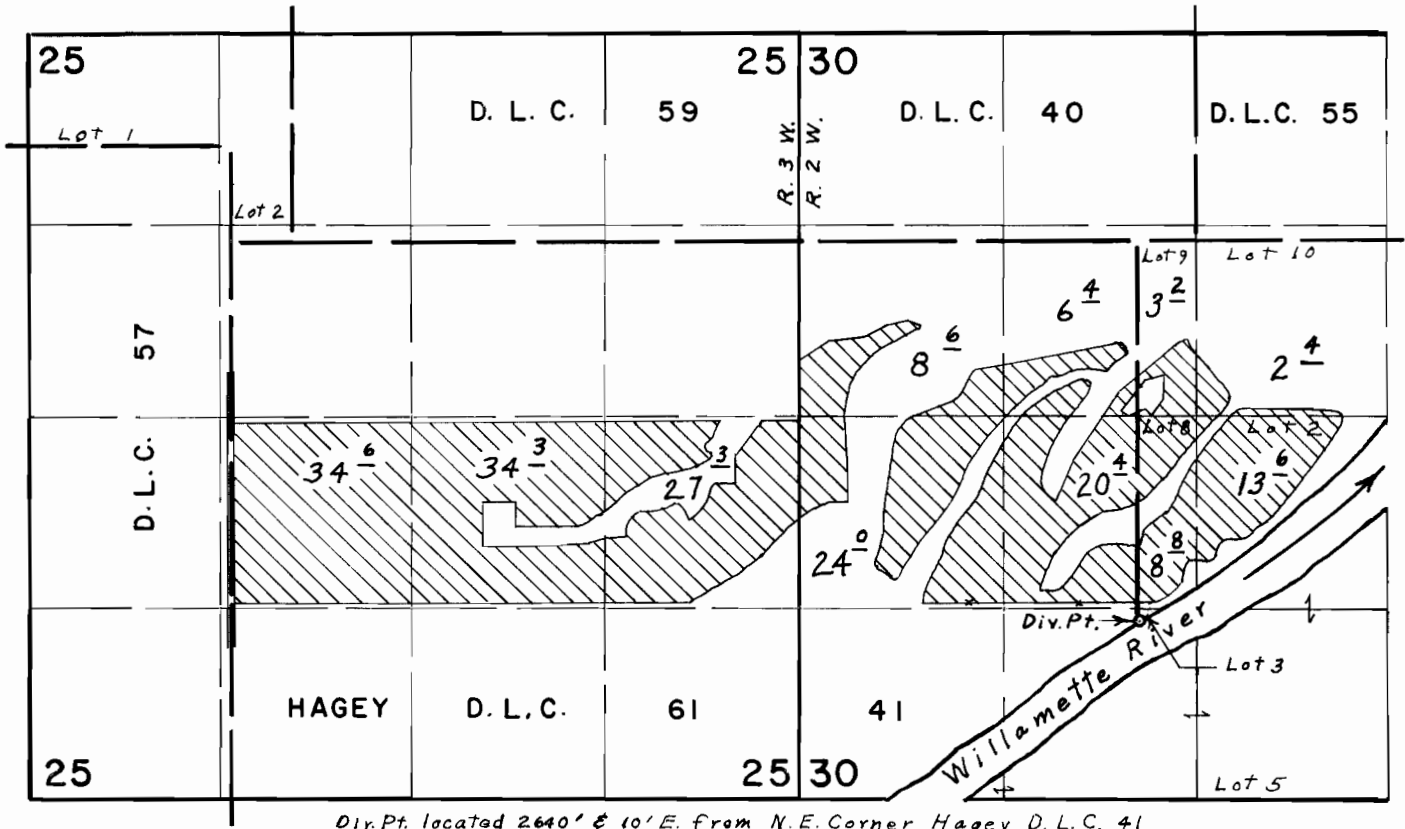

Div. Pt. located 2640' ± 10' E. from N.E. Corner Hagey D. L.C. 41

FINAL PROOF SURVEY UNDER

Application No. 42962 Permit No. 32097
IN NAME OF

RICHARD & WALTER RACETTE

Surveyed Aug. 19, 1977, by L. E. Gould