


T. 3 & 4 S. R. 4 W. W. M.

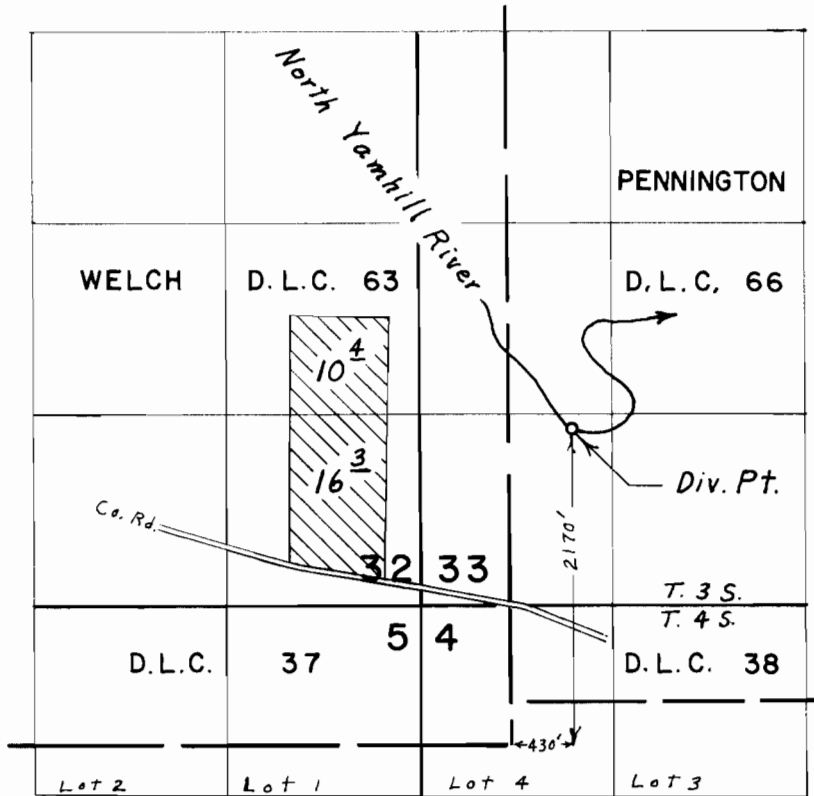

FINAL PROOF SURVEY UNDER

Application No. 43332 Permit No. 32389
IN NAME OF

SITTON BROS. INC.

Surveyed Sept. 8, 1971, by L. E. Gould