


T. 3 S. R. 3 W. W. M.

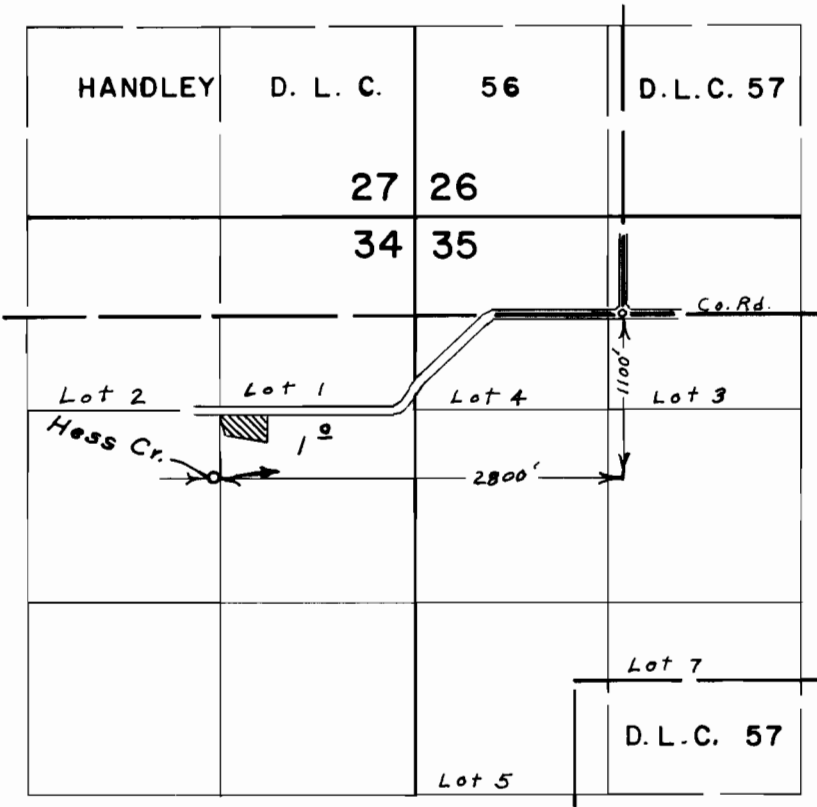

FINAL PROOF SURVEY UNDER

Application No. 45332 Permit No. 33837
IN NAME OF

DARICE C. and BOBBE L. SHALBERG

Surveyed Sept. 8, 1971, by L. E. Gould