


T. 5 S. R. 1 W. W. M.

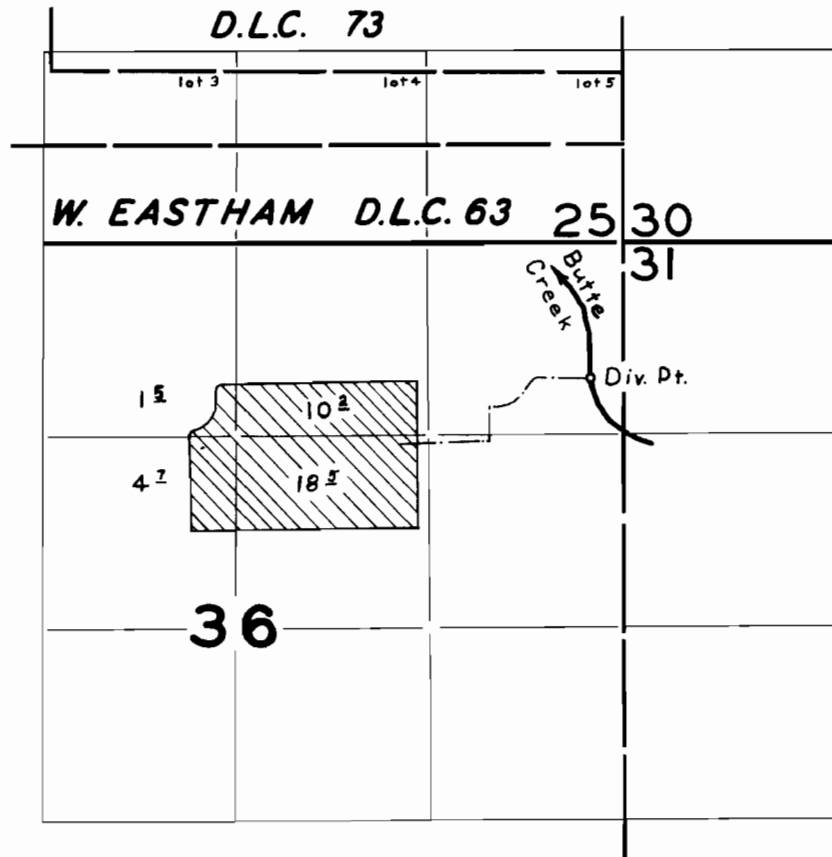

FINAL PROOF SURVEY
UNDER

Application No. 34799 Permit No. 27334
IN NAME OF

WALTER DUDA

Surveyed APR. 7 1964, by R. JACKSON