


T. 35 & 36 S. R. 1 W. W.M.

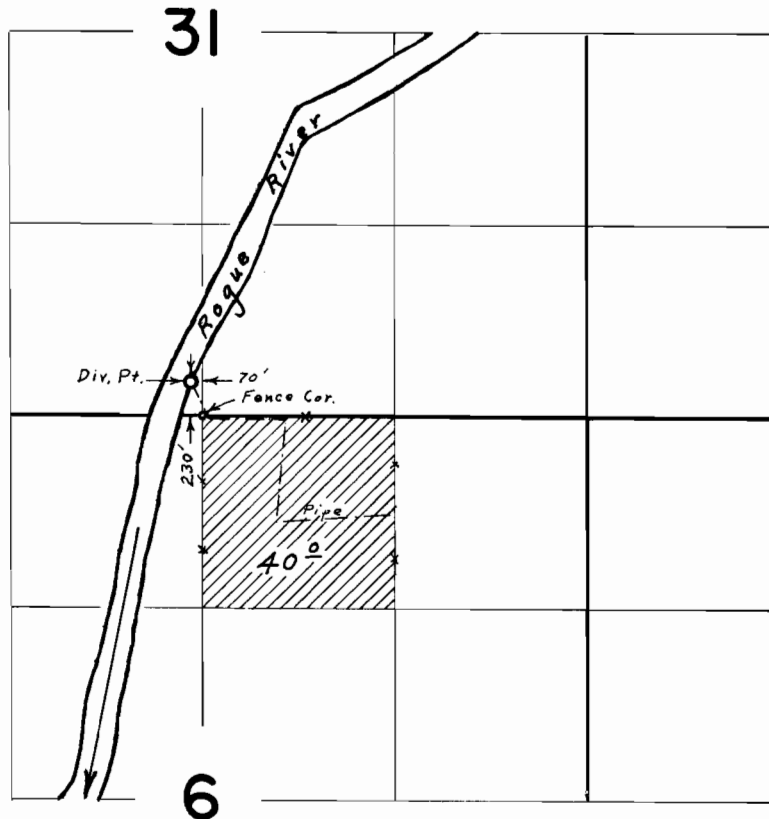

FINAL PROOF SURVEY
UNDER

Transfer H-171
Application No. Permit No.
IN NAME OF
HERMAN HUEBNER

Surveyed *May 24, 1968*, by *L. E. Gould*.